


MATCHLINE STATION 85+94
SEE DWG CAM14799P020R1

MATCHLINE STATION 91+01
SEE DWG CAM14799P022R1



REV	DATE	DESCRIPTION	DESIGNED	CHECKED	APPROVED
1	MAR2002	AS-BUILT	RM	MS	ES
2	4/16/03	Changed Level 3 reference to JTP	LM	BW	BW

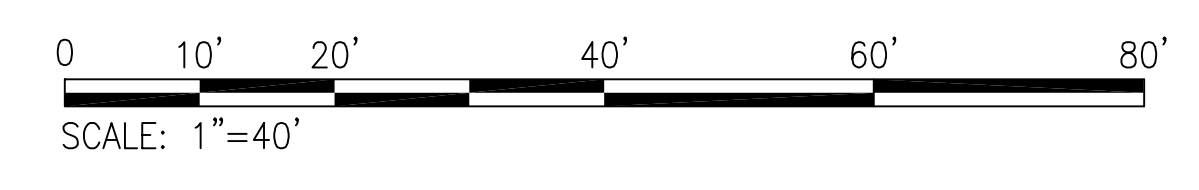

SULLIVAN & MCLAUGHLIN CO.
74 LAWLEY STREET, BOSTON, MA 02122
PHONE: (617) 474-0500 FAX: (617) 474 0505

CONFIDENTIAL
FOR PROPRIETARY USE ONLY
EXCEPT AS MAY BE OTHERWISE PROVIDED
THIS DRAWING SHALL REMAIN THE PROPERTY OF
Level (3)
COMMUNICATIONS
AND SHALL NOT BE REPRODUCED, COPIED, OR USED FOR
ANY PURPOSE WITHOUT SPECIFIC WRITTEN PERMISSION.

DRAWN BY: RM
CHECKED BY: MS
APPROVED BY: ES



Level (3)SM
COMMUNICATIONS

LOOP: B LOOP
SEGMENT: B-1A;B-1B;B-1C;B-1D;B-2;B-3
B-4;B-5;B-6;B-6B;B-6A;B-7;B-8;A-1
SITE ADDRESS: CAMBRIDGE ST
CAMBRIDGE, MA

TITLE: AS-BUILT PLAN

CONTRACT NO: 14799
DRAWING NO: CAM14799P021R1
DATE DRAWN: MARCH2002
SCALE: 1" = 40'
PLOT DATE: 4/16/03

SHEET: 25 OF: 37

25