


MATCHLINE STATION 110+83  
SEE DWG CAM14799P025R1

MATCHLINE STATION 115+63  
SEE DWG CAM14799P027R1




REV	DATE	DESCRIPTION	DESIGNED	CHECKED	APPROVED
1	MAR2002	AS-BUILT	RM	MS	ES
2	4/16/03	Changed Level 3 reference to JTP	LW	BW	BW

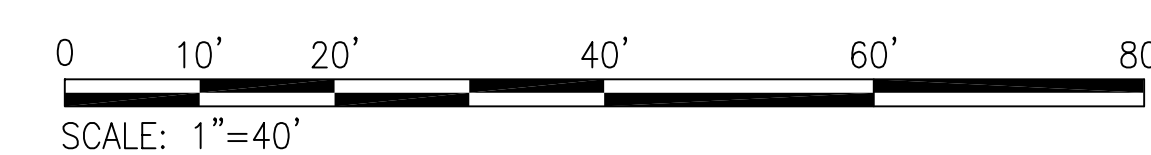

**SULLIVAN & MCLAUGHLIN CO.**  
74 LAWLEY STREET, BOSTON, MA 02122  
PHONE: (617) 474-0500 FAX: (617) 474 0505

**CONFIDENTIAL**  
FOR PROPRIETARY USE ONLY  
EXCEPT AS MAY BE OTHERWISE PROVIDED  
THIS DRAWING SHALL REMAIN THE PROPERTY OF  
**Level (3)**  
COMMUNICATIONS  
AND SHALL NOT BE REPRODUCED, COPIED, OR USED FOR  
ANY PURPOSE WITHOUT SPECIFIC WRITTEN PERMISSION.

DRAWN BY: RM  
CHECKED BY: MS  
APPROVED BY: ES

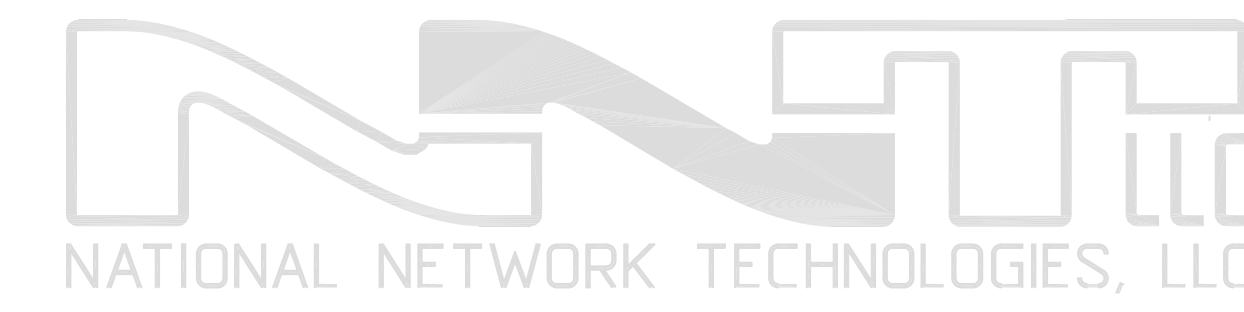

**Level (3)**<sup>SM</sup>  
COMMUNICATIONS

LOOP: B LOOP  
SEGMENT: B-1A;B-1B;B-1C;B-1D;B-2;B-3  
B-4;B-5;B-6B;B-6;B-6A;B-7;B-8;A-1  
SITE ADDRESS: CAMBRIDGE ST  
CAMBRIDGE, MA

TITLE: AS-BUILT PLAN

CONTRACT NO: 14799  
DRAWING NO: CAM14799P026R1  
DATE DRAWN: MARCH2002  
SCALE: 1" = 40'  
PLOT DATE: 4/16/03

SHEET: 30 OF: 37