

REV	DATE	DESCRIPTION	DESIGNED	CHECKED	APPROVED
1	MAR2002	AS-BUILT	RM	MS	ES
2	4/16/03	Changed Level 3 reference to JTP	LM	BW	BW



SULLIVAN & MCLAUGHLIN CO.
 74 LAWLEY STREET, BOSTON, MA 02122
 PHONE: (617) 474-0500 FAX: (617) 474 0505

CONFIDENTIAL
 FOR PROPRIETARY USE ONLY
 EXCEPT AS MAY BE OTHERWISE PROVIDED
 THIS DRAWING SHALL REMAIN THE PROPERTY OF
Level (3)
 COMMUNICATIONS
 AND SHALL NOT BE REPRODUCED, COPIED, OR USED FOR
 ANY PURPOSE WITHOUT SPECIFIC WRITTEN PERMISSION.

DRAWN BY: RM
 CHECKED BY: MS
 APPROVED BY: ES





Level (3)SM
 COMMUNICATIONS

LOOP: B LOOP
 SEGMENT: B-1A;B-1B;B-1C;B-1D;B-2;B-3
 B-4;B-5;B-6;B-6A;B-7;B-8;A-1
 SITE ADDRESS: THIRD ST
 CAMBRIDGE, MA

TITLE: AS-BUILT PLAN

CONTRACT NO: 14799
 DRAWING NO: CAM14799P028R1
 DATE DRAWN: MARCH2002
 SCALE: 1" = 40'
 PLOT DATE: 4/16/03

SHEET: 32 OF: 37

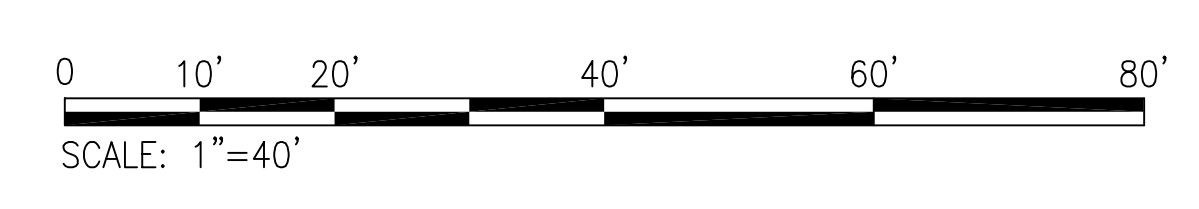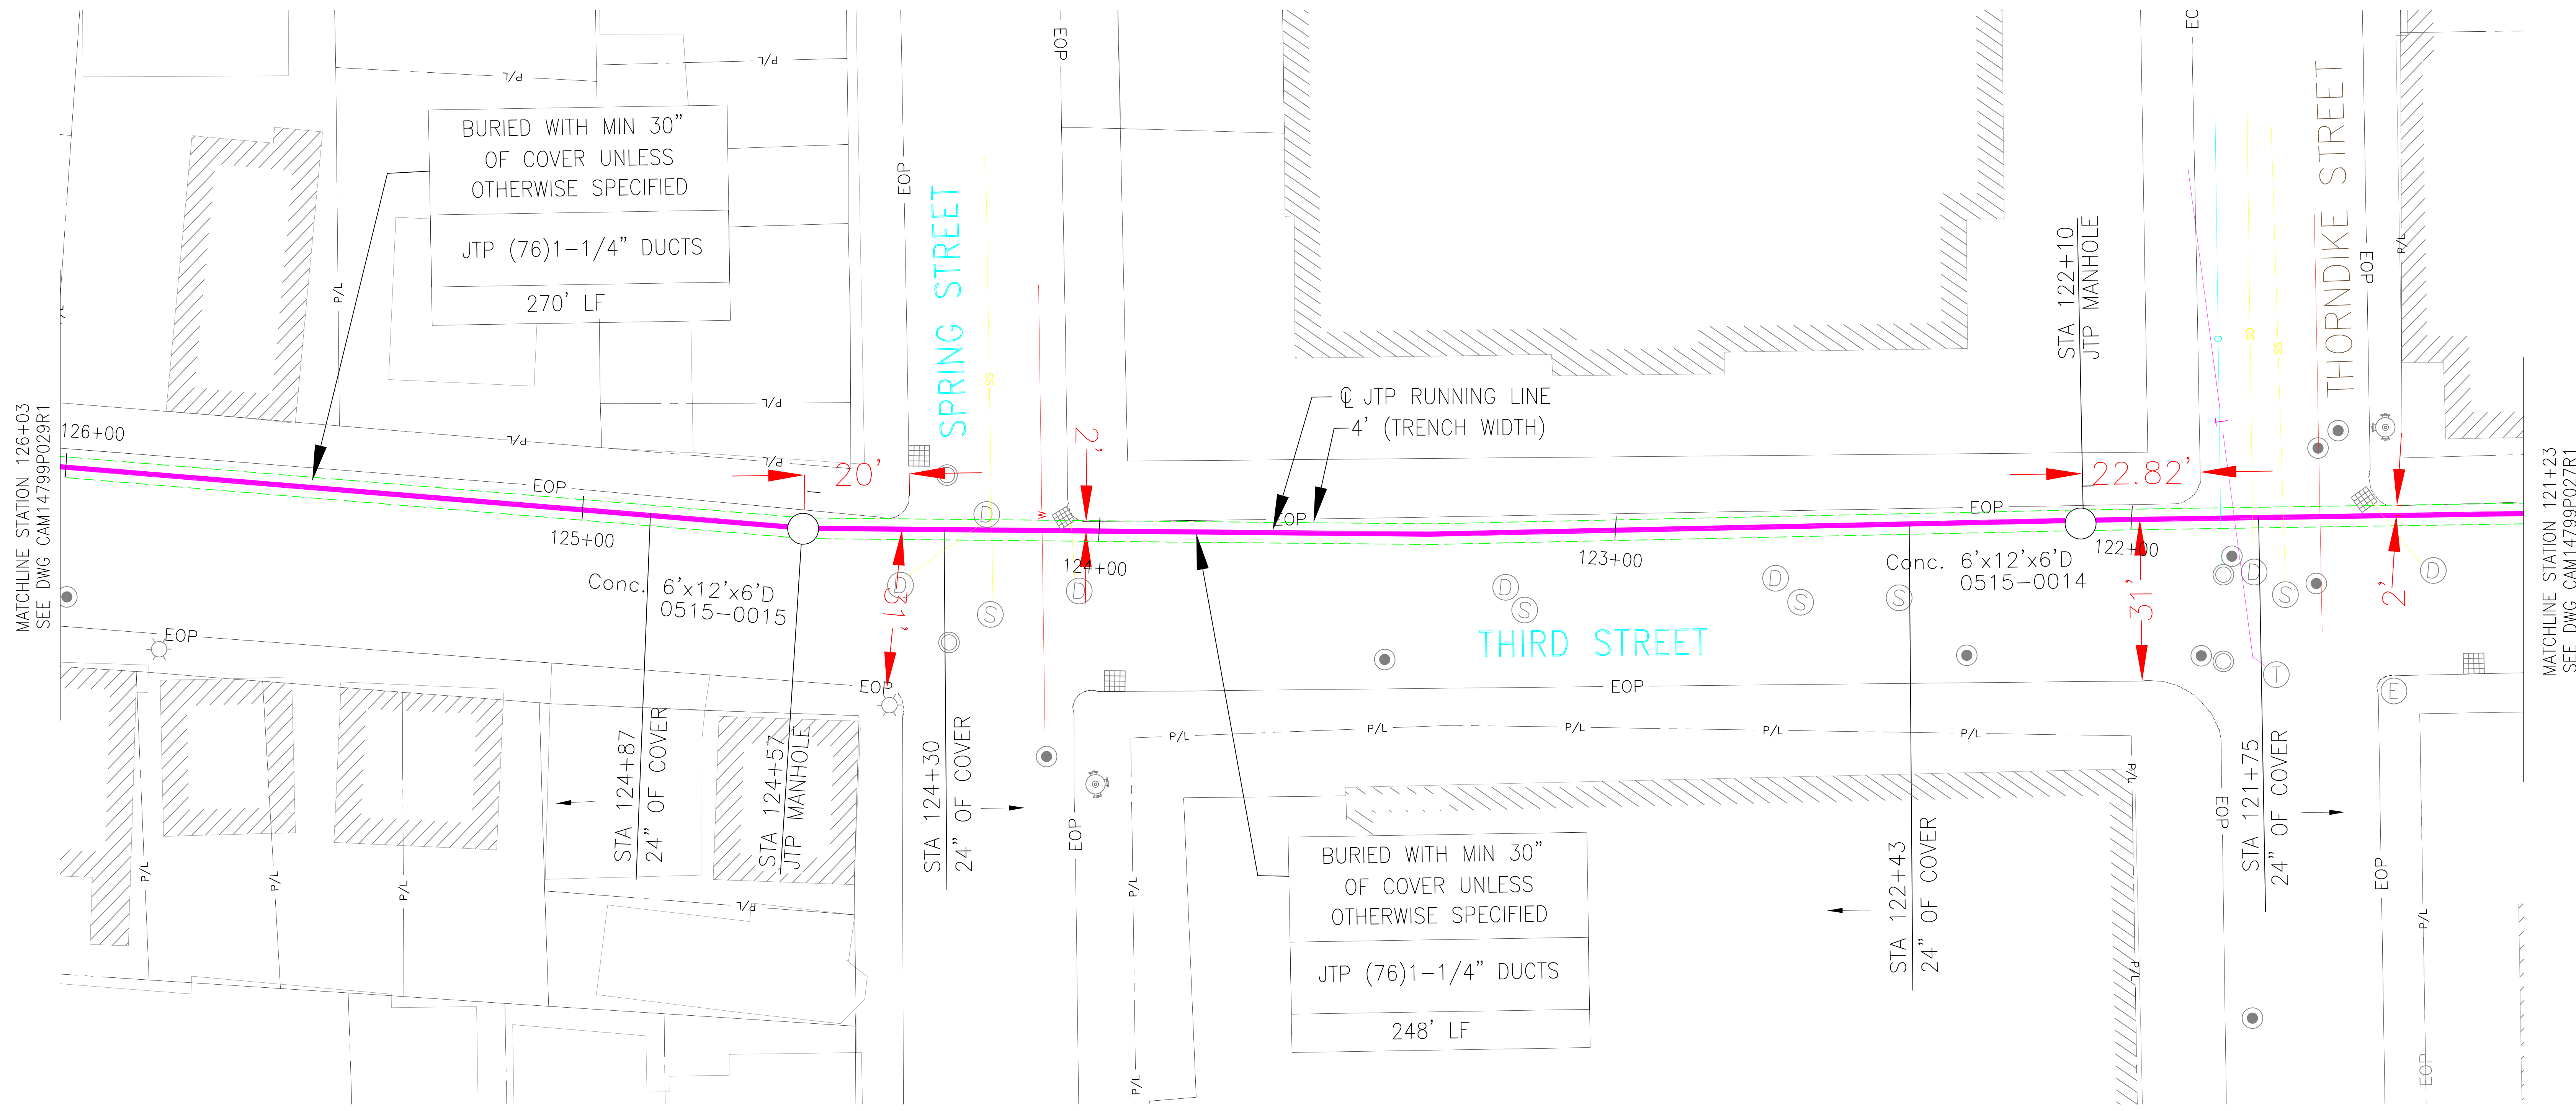

MATCHLINE STATION 126+03
 SEE DWG CAM14799P028R1

MATCHLINE STATION 121+23
 SEE DWG CAM14799P028R1