

BURIED WITH MIN 30\"/>

JTP (36)-1 1/4\"/>

466' LF-c/c


REV	DATE	DESCRIPTION	DESIGNER	CHECKED	APPROVED
1	NOV2001	AS BUILT	RM	ES	MS
2	4/22/03	Changed Level 3 reference to JTP	LM	BW	BW



SULLIVAN & MCLAUGHLIN CO.
 74 LAWLEY STREET, BOSTON, MA 02122
 PHONE: (617) 474-0500 FAX: (617) 474 0505

CONFIDENTIAL
 FOR PROPRIETARY USE ONLY
 EXCEPT AS MAY BE OTHERWISE PROVIDED
 THIS DRAWING SHALL REMAIN THE PROPERTY OF
Level (3)
 COMMUNICATIONS
 AND SHALL NOT BE REPRODUCED, COPIED, OR USED FOR
 ANY PURPOSE WITHOUT SPECIFIC WRITTEN PERMISSION.

DRAWN BY: R. MEJIA
 CHECKED BY: E. SPITZER
 APPROVED BY: M. SARACENO

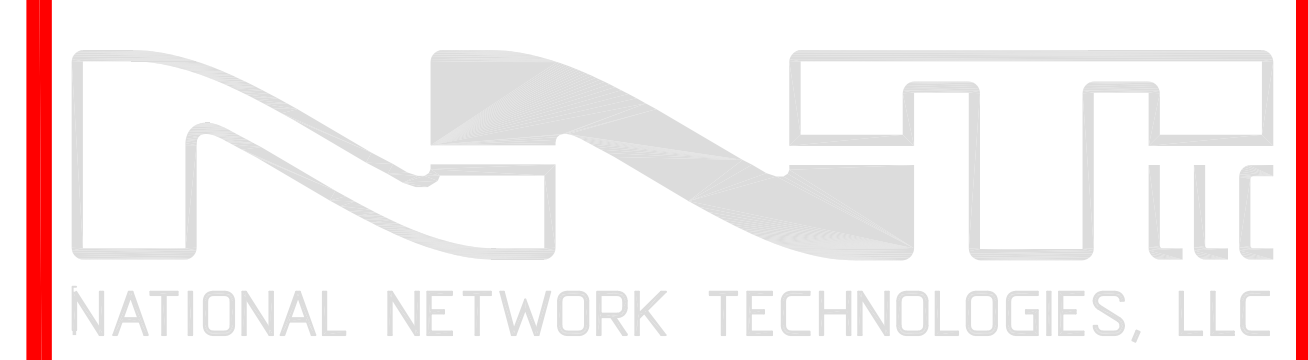

Level (3)SM
 COMMUNICATIONS

LOOP: SOMERVILLE
 SEGMENT: E-3
 SITE ADDRESS: McGRATH HIGHWAY
 CAMBRIDGE, MA

TITLE: AS-BUILT PLAN

CONTRACT NO: 8728
 DRAWING NO: CAM8728P009R1
 DATE DRAWN: NOV 2001
 SCALE: 1" = 40'
 PLOT DATE: 4/22/03

SHEET: 16 OF 19

