


SEE DWG CAMSC1430-02P001R1  
MATCHLINE STATION 04+43

SEE DWG CAMSC1430-02P003R1  
MATCHLINE STATION 08+51

BURIED WITH MIN 30"  
OF COVER UNLESS  
OTHERWISE SPECIFIED

JTP (44)  
1-1/4" DUCTS  
577' LF

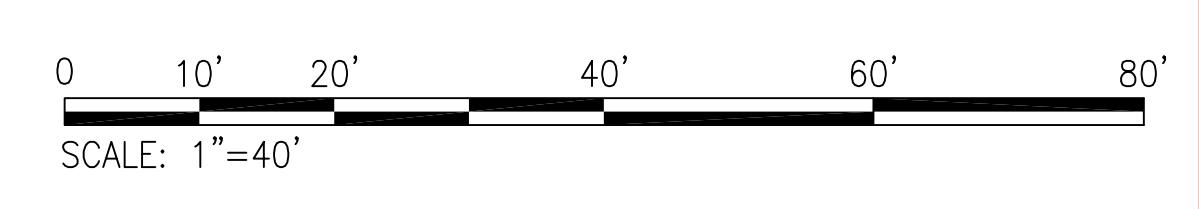

REV	DATE	DESCRIPTION	DESIGNED	CHECKED	APPROVED
1	MAR2001	AS BUILT	RM	JB	HE
2	4/16/03	Changed Level 3 reference to JTP	LM	BW	BW



**SULLIVAN & McLAUGHLIN CO.**  
74 LAWLEY STREET, BOSTON, MA 02122  
PHONE: (617) 474-0500 FAX: (617) 474 0505

**CONFIDENTIAL**  
FOR PROPRIETARY USE ONLY  
EXCEPT AS MAY BE OTHERWISE PROVIDED  
THIS DRAWING SHALL REMAIN THE PROPERTY OF  
**Level (3)**  
COMMUNICATIONS  
AND SHALL NOT BE REPRODUCED, COPIED, OR USED FOR  
ANY PURPOSE WITHOUT SPECIFIC WRITTEN PERMISSION.

DRAWN BY: R. MEJIA  
CHECKED BY: J. DE BARROS  
APPROVED BY: H. BERTONI



**Level (3)**<sup>SM</sup>  
COMMUNICATIONS

LOOP: CAMBRIDGE  
SEGMENT: B-1 LOOP  
SITE ADDRESS: CAMBRIDGE, MA

TITLE: FULKERSON ST.

CONTRACT NO: SC1430-02  
DRAWING NO: CAMSC1430-02P002R1  
DATE DRAWN: APR2000  
SCALE: 1"=40"  
PLOT DATE: 4/16/03

SHEET: 6 OF: 19

06