


REV	DATE	DESCRIPTION	DESIGN	CHECK	APPV
1	MAR2001	AS BUILT	RM	JB	TBB
2	4/16/03	Changed Level 3 reference to JTP	LM	BW	EW



SULLIVAN & MCLAUGHLIN CO.
 74 LAWLEY STREET, BOSTON, MA 02122
 PHONE: (617) 474-0500 FAX: (617) 474 0505

CONFIDENTIAL
 FOR PROPRIETARY USE ONLY
 EXCEPT AS MAY BE OTHERWISE PROVIDED
 THIS DRAWING SHALL REMAIN THE PROPERTY OF
Level(3)
 COMMUNICATIONS
 AND SHALL NOT BE REPRODUCED, COPIED, OR USED FOR
 ANY PURPOSE WITHOUT SPECIFIC WRITTEN PERMISSION.

DRAWN BY: R. MEJIA
 CHECKED BY: J. DEBARROS
 APPROVED BY: H. BERTONI

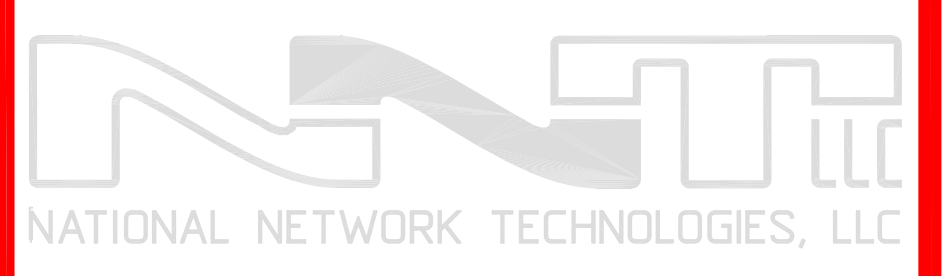

Level(3)
 COMMUNICATIONS

LOOP: CAMBRIDGE
 SEGMENT: B-1 LOOP
 SITE ADDRESS: CAMBRIDGE, MA
 TITLE: BENT ST

CONTRACT NO: SC1430-02 SHEET:
 DRAWING NO: CAMSC1430-02P014R1
 DATE DRAWN: APR2000
 SCALE: 1"=40'
 PLOT DATE: 4/16/03 SHEET:18 OF: 19

