

REV	DATE	DESCRIPTION	DESIGNED	CHECKED	BY
1	FEB2001	AS BUILT	FM	JB	HL
2	4/18/03	Changed Level 3 reference to JTP	LW	BW	BW



SULLIVAN & MCLAUGHLIN CO.
 74 LAWLEY STREET, BOSTON, MA 02122
 PHONE: (617) 474-0500 FAX: (617) 474 0505

CONFIDENTIAL
 FOR PROPRIETARY USE ONLY
 EXCEPT AS MAY BE OTHERWISE PROVIDED
 THIS DRAWING SHALL REMAIN THE PROPERTY OF
Level(3)
 COMMUNICATIONS
 AND SHALL NOT BE REPRODUCED, COPIED, OR USED FOR
 ANY PURPOSE WITHOUT SPECIFIC WRITTEN PERMISSION.

DRAWN BY: R. MEJIA
 CHECKED BY: J. DEBARROS
 APPROVED BY: H. BERTONI




Level(3)SM
 COMMUNICATIONS

LOOP: SOMERVILLE
 SEGMENT: E-1
 SITE ADDRESS: SOMERVILLE, MA

TITLE: SOMERVILLE AVENUE

CONTRACT NO: 1434	SHEET: 07 OF: 8
DRAWING NO: SOM1434P003R1	
DATE DRAWN: FEB2001	
SCALE: 1" = 40'	
PLOT DATE: 4/18/03	

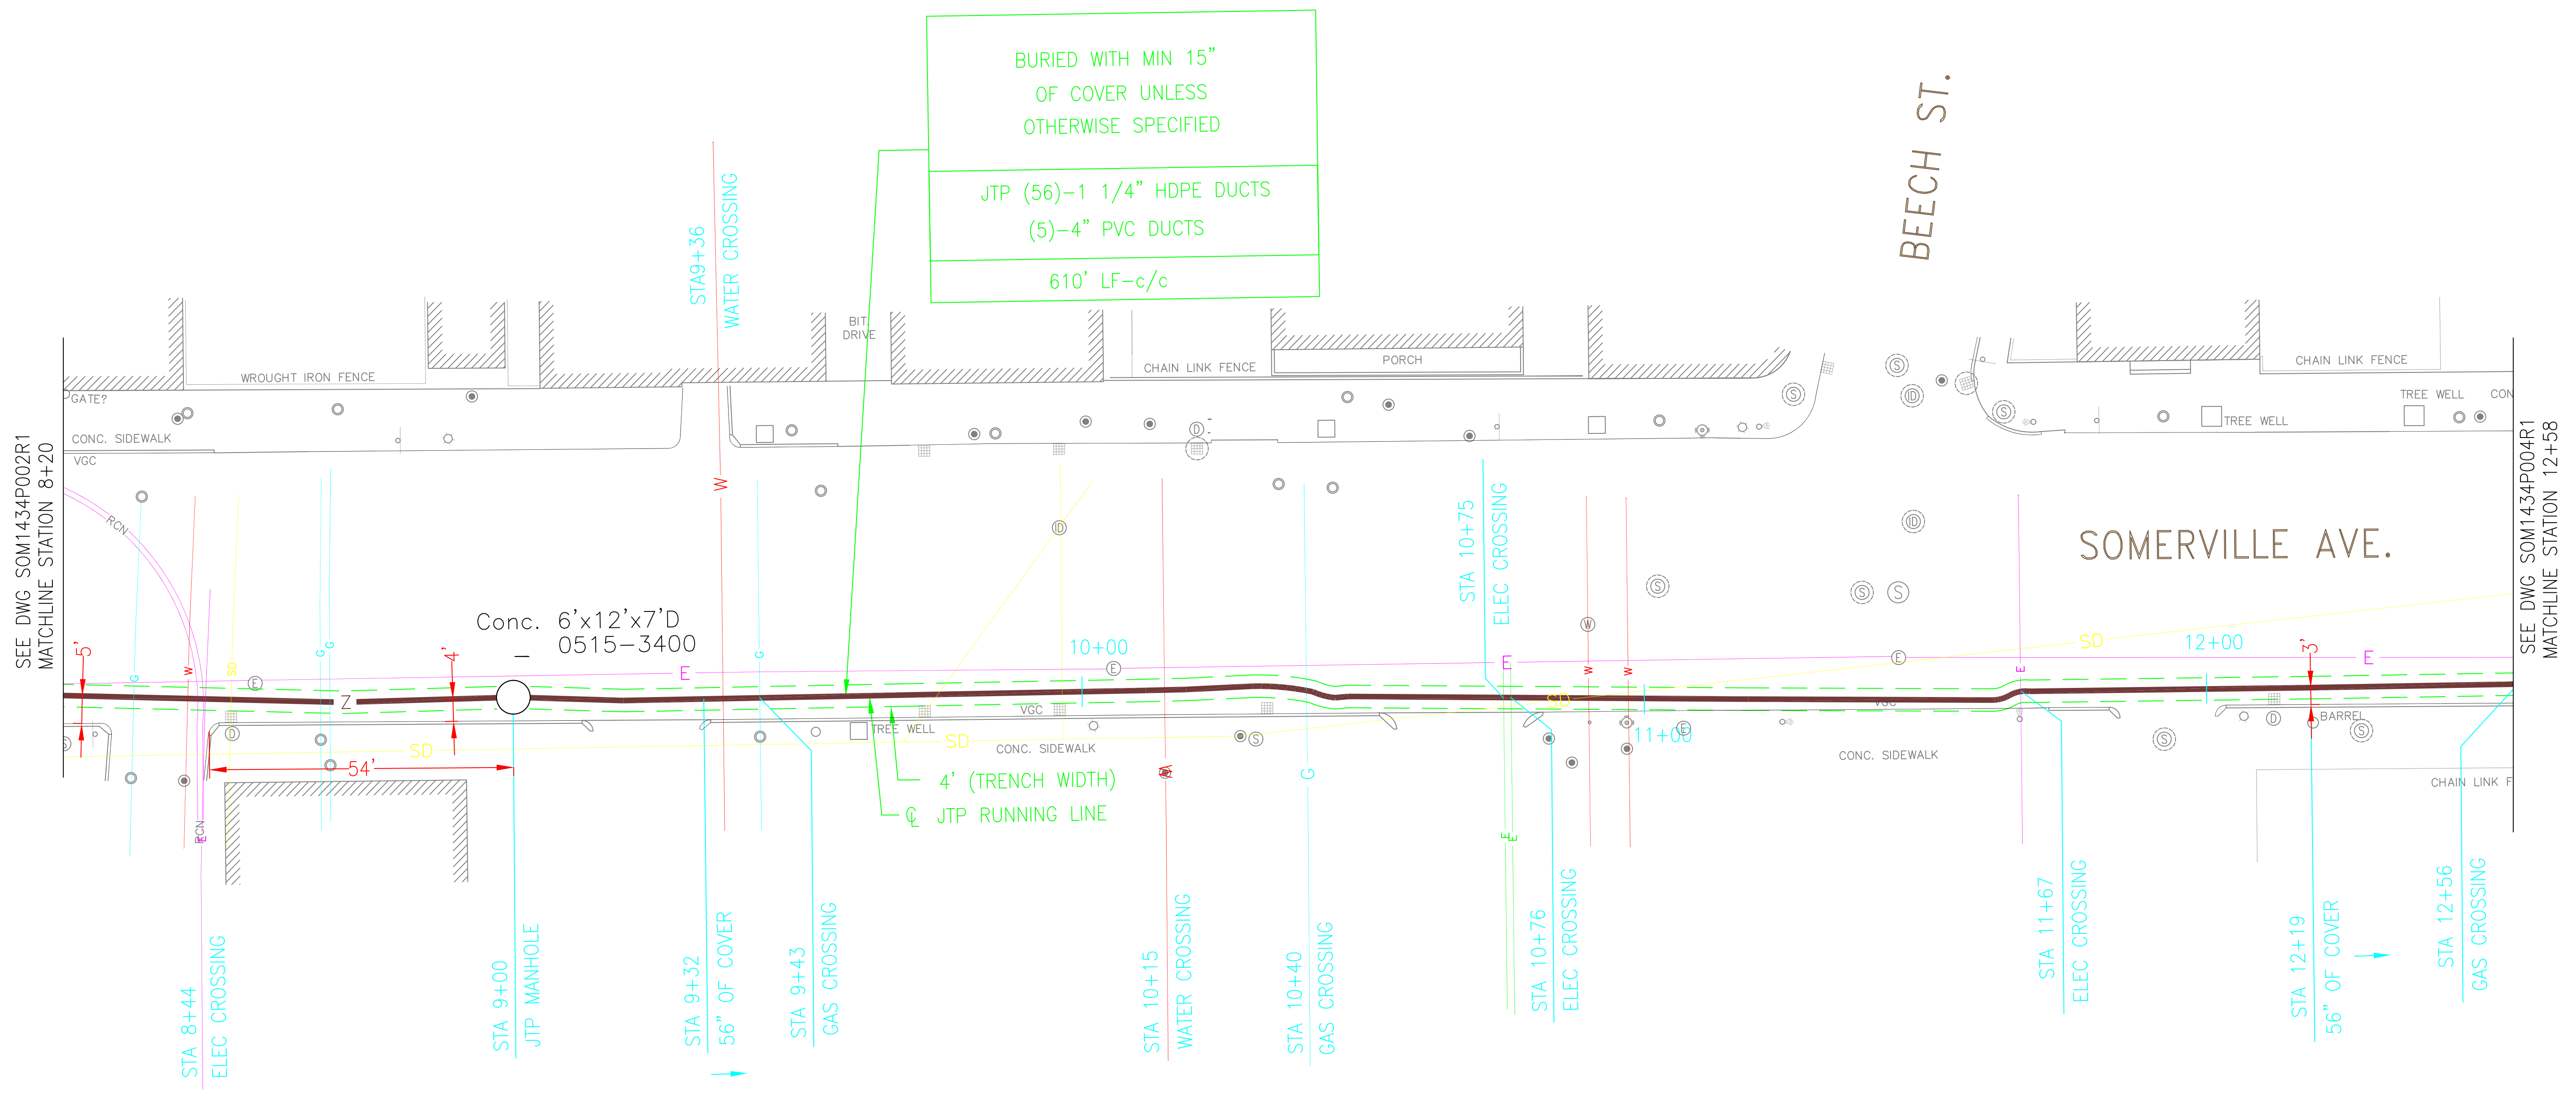

BURIED WITH MIN 15"
 OF COVER UNLESS
 OTHERWISE SPECIFIED

JTP (56)-1 1/4" HDPE DUCTS
 (5)-4" PVC DUCTS
 610' LF-c/c

