


SEE DWG SOM1434P003R1
MATCHLINE STATION 12+58



REV	DATE	DESCRIPTION	DESIGNED	CHECKED	BY
1	FEB2001	AS BUILT	TM	JB	HE
2	4/18/03	Changed Level 3 reference to JTP	LM	BW	EB

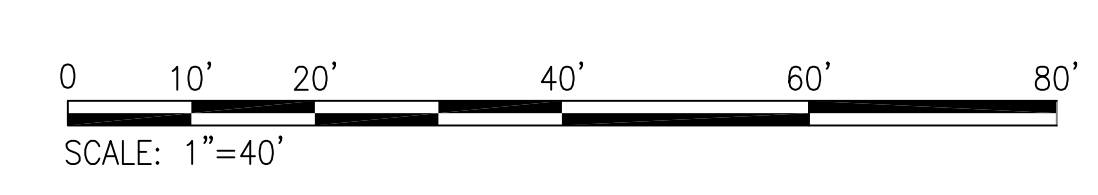

SULLIVAN & MCLAUGHLIN CO.
74 LAWLEY STREET, BOSTON, MA 02122
PHONE: (617) 474-0500 FAX: (617) 474 0505

CONFIDENTIAL
FOR PROPRIETARY USE ONLY
EXCEPT AS MAY BE OTHERWISE PROVIDED
THIS DRAWING SHALL REMAIN THE PROPERTY OF
Level (3)
COMMUNICATIONS
AND SHALL NOT BE REPRODUCED, COPIED, OR USED FOR
ANY PURPOSE WITHOUT SPECIFIC WRITTEN PERMISSION.

DRAWN BY: R. MEJIA
CHECKED BY: J. DEBARROS
APPROVED BY: H. BERTONI



Level (3)SM
COMMUNICATIONS

LOOP: SOMERVILLE
SEGMENT: E-1
SITE ADDRESS: SOMERVILLE, MA

TITLE: SOMERVILLE AVENUE

CONTRACT NO: 1434	SHEET: 08 8 OF 8
DRAWING NO: SOM1434P004R1	
DATE DRAWN: FEB2001	
SCALE: 1" = 40'	
PLOT DATE: 4/18/03	