

REV	DATE	DESCRIPTION	DESIGNER	CHECKED	APPROVED
1	NOV2001	AS BUILT	RM	ES	MS
2	4/18/03	Changed Level 3 reference to JTP	LM	BW	BW



SULLIVAN & MCLAUGHLIN CO.
 74 LAWLEY STREET, BOSTON, MA 02122
 PHONE: (617) 474-0500 FAX: (617) 474 0505

CONFIDENTIAL
 FOR PROPRIETARY USE ONLY
 EXCEPT AS MAY BE OTHERWISE PROVIDED
 THIS DRAWING SHALL REMAIN THE PROPERTY OF
Level (3)
 COMMUNICATIONS
 AND SHALL NOT BE REPRODUCED, COPIED, OR USED FOR
 ANY PURPOSE WITHOUT SPECIFIC WRITTEN PERMISSION.

DRAWN BY: R. MEJIA
 CHECKED BY: E. SPITZER
 APPROVED BY: M. SARACENO




Level (3)SM
 COMMUNICATIONS

LOOP: SOMERVILLE
 SEGMENT: E-3
 SITE ADDRESS: POPLAR STREET
 SOMERVILLE, MA

TITLE: AS-BUILT PLAN

CONTRACT NO: 8728	SHEET: 08
DRAWING NO: SOM8728P001R1	
DATE DRAWN: NOV 2001	
SCALE: 1" = 40'	
PLOT DATE: 4/18/03	SHEET: 8 OF: 19

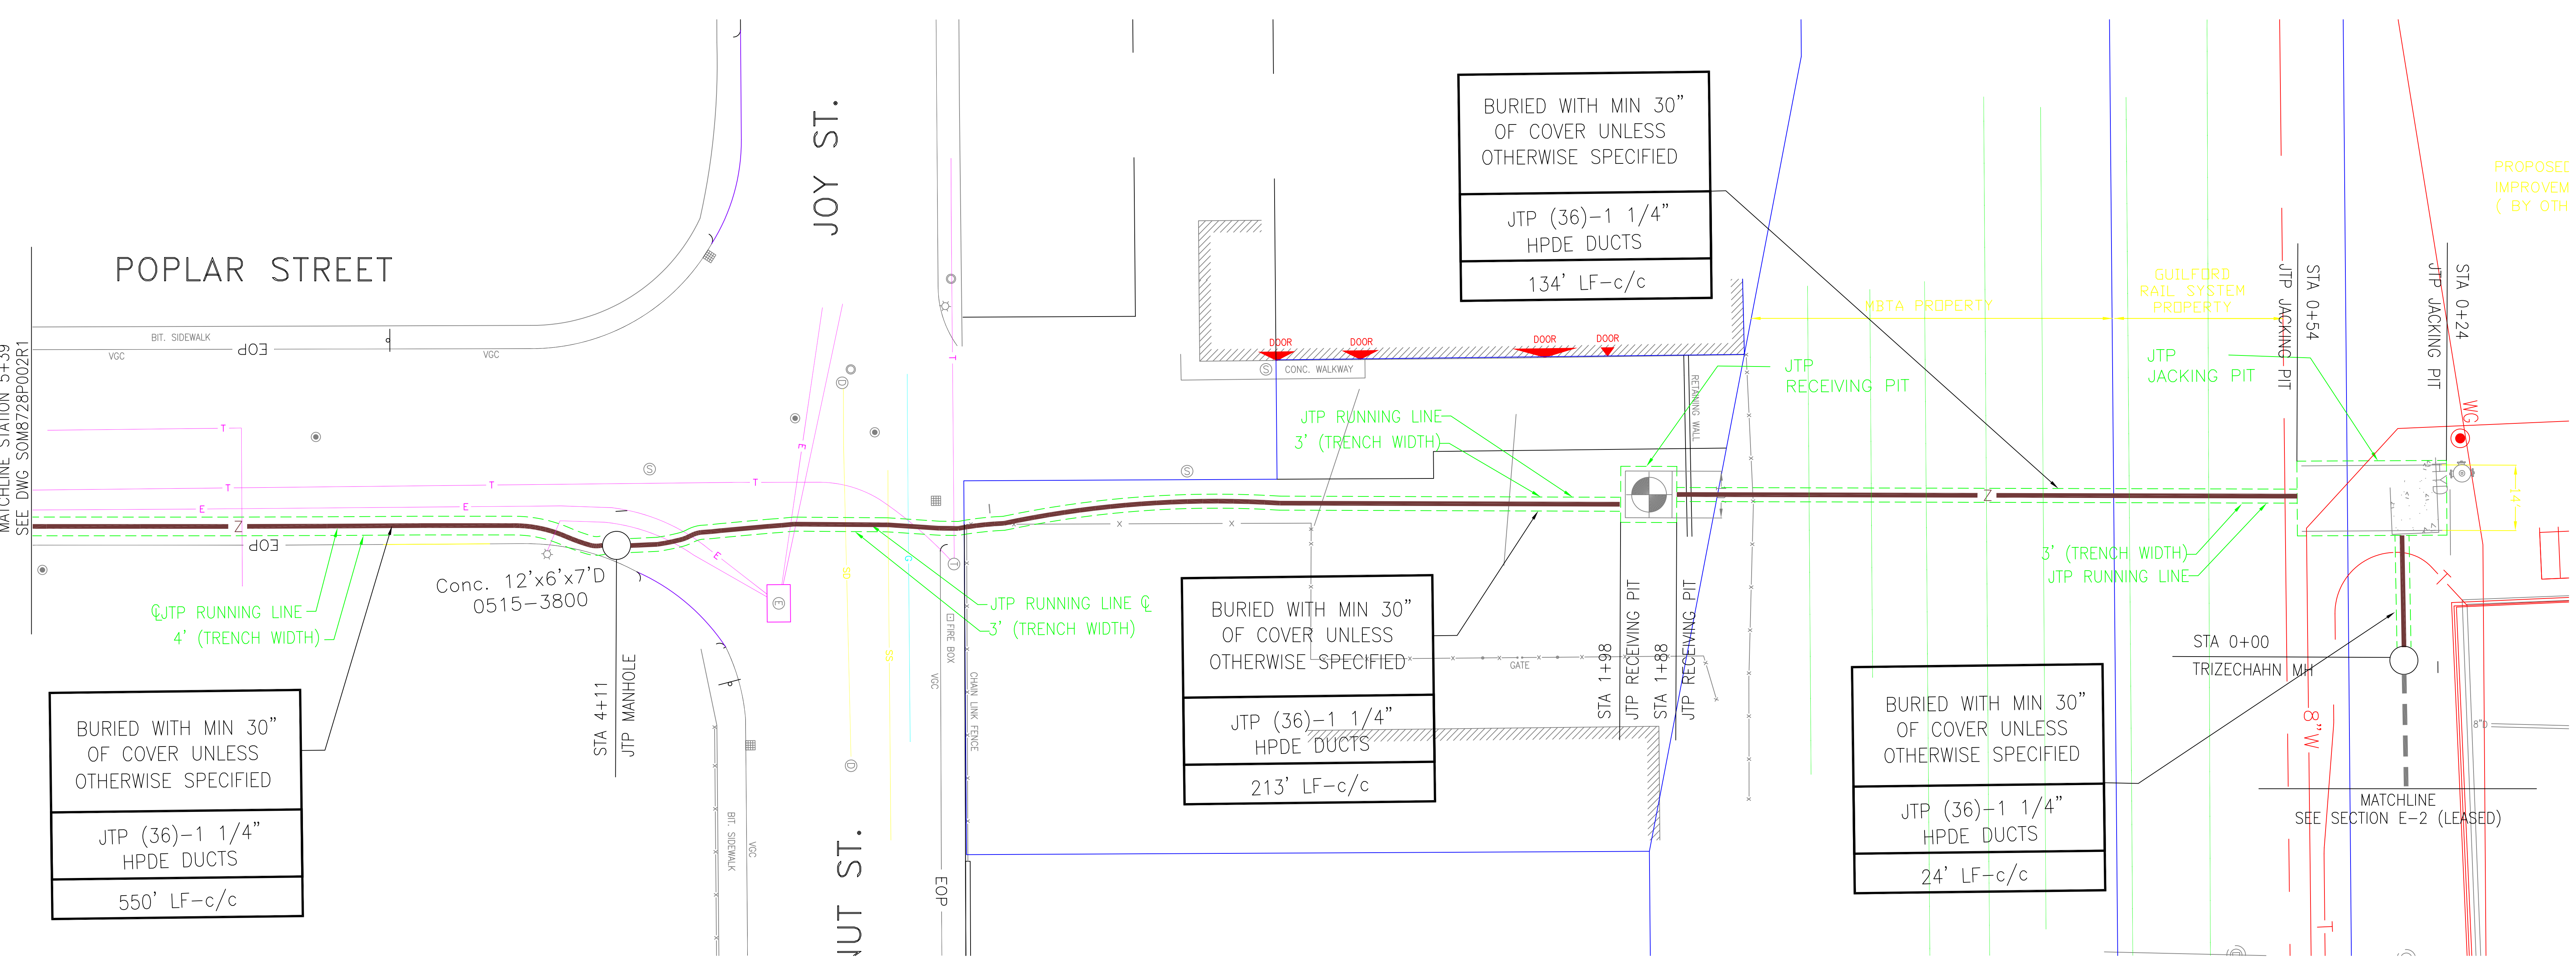

MATCHLINE STATION 5+39
SEE DWG. SOM8728P002R1

PROPOSED IMPROVEM (BY OTH