


REV	DATE	DESCRIPTION	DESIGNER	CHECKED	APPROVED
1	NOV2001	AS BUILT	RM	ES	MS
2	4/18/03	Changed Level 3 reference to JTP	LM	BW	BW



**SULLIVAN & MCLAUGHLIN CO.**  
 74 LAWLEY STREET, BOSTON, MA 02122  
 PHONE: (617) 474-0500 FAX: (617) 474 0505

**CONFIDENTIAL**  
 FOR PROPRIETARY USE ONLY  
 EXCEPT AS MAY BE OTHERWISE PROVIDED  
 THIS DRAWING SHALL REMAIN THE PROPERTY OF  
**Level (3)**  
 COMMUNICATIONS  
 AND SHALL NOT BE REPRODUCED, COPIED, OR USED FOR  
 ANY PURPOSE WITHOUT SPECIFIC WRITTEN PERMISSION.

DRAWN BY: R. MEJIA  
 CHECKED BY: E. SPITZER  
 APPROVED BY: M. SARACENO

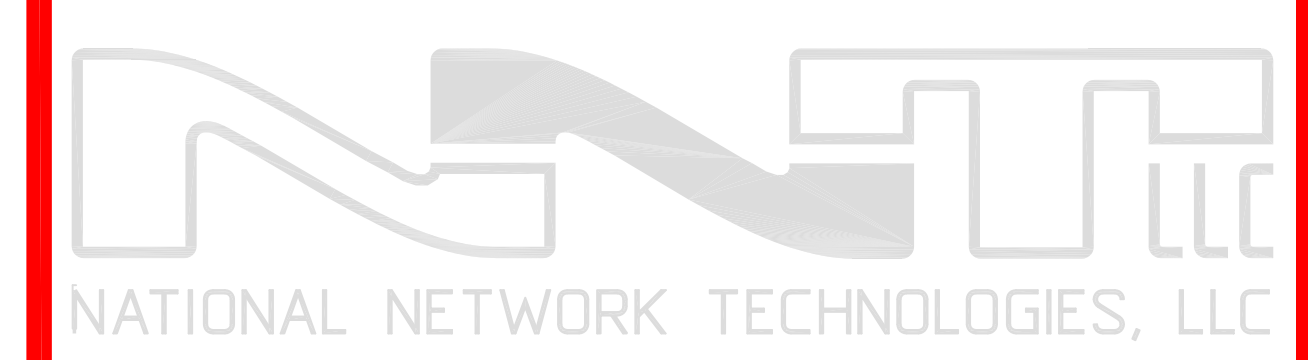

**Level (3)**<sup>SM</sup>  
 COMMUNICATIONS

LOOP: SOMERVILLE  
 SEGMENT: E-3  
 SITE ADDRESS: McGRATH HIGHWAY  
 SOMERVILLE, MA

TITLE: AS-BUILT PLAN

CONTRACT NO: 8728	SHEET: 10 OF 19
DRAWING NO: SOM8728P003R1	
DATE DRAWN: NOV 2001	
SCALE: 1" = 40'	
PLOT DATE: 4/18/03	

