


BURIED WITH MIN 30"  
OF COVER UNLESS  
OTHERWISE SPECIFIED

JTP (36)-1 1/4"  
HPDE DUCTS

496' LF-c/c

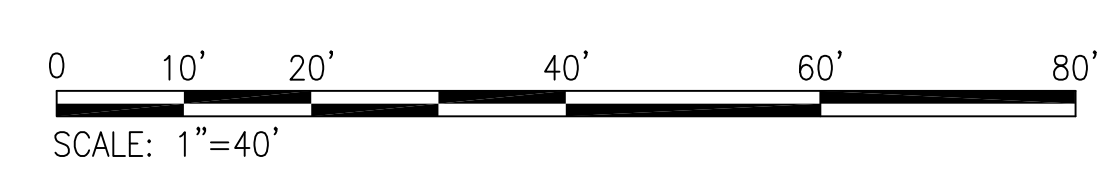

REV	DATE	DESCRIPTION	DESIGNER	CHECKED	APPROVED
1	NOV2001	AS BUILT	RM	ES	MS
2	4/22/03	Changed Level 3 reference to JTP	LM	BW	BW



**SULLIVAN & MCLAUGHLIN CO.**  
74 LAWLEY STREET, BOSTON, MA 02122  
PHONE: (617) 474-0500 FAX: (617) 474 0505

**CONFIDENTIAL**  
FOR PROPRIETARY USE ONLY  
EXCEPT AS MAY BE OTHERWISE PROVIDED  
THIS DRAWING SHALL REMAIN THE PROPERTY OF  
**Level (3)**  
COMMUNICATIONS  
AND SHALL NOT BE REPRODUCED, COPIED, OR USED FOR  
ANY PURPOSE WITHOUT SPECIFIC WRITTEN PERMISSION.

DRAWN BY: R. MEJIA  
CHECKED BY: E. SPITZER  
APPROVED BY: M. SARACENO



**Level (3)**<sup>SM</sup>  
COMMUNICATIONS

LOOP: SOMERVILLE  
SEGMENT: E-3  
SITE ADDRESS: McGRATH HIGHWAY  
SOMERVILLE, MA

TITLE: AS-BUILT PLAN

CONTRACT NO: 8728	SHEET:  <b>11</b>
DRAWING NO: SOM8728P004R1	
DATE DRAWN: NOV 2001	
SCALE: 1" = 40'	
PLOT DATE: 4/22/03	SHEET: 11 OF: 19