


BURIED WITH MIN 30"
OF COVER UNLESS
OTHERWISE SPECIFIED


JTP (36)-1 1/4"
HPDE DUCTS

931' LF-c/c

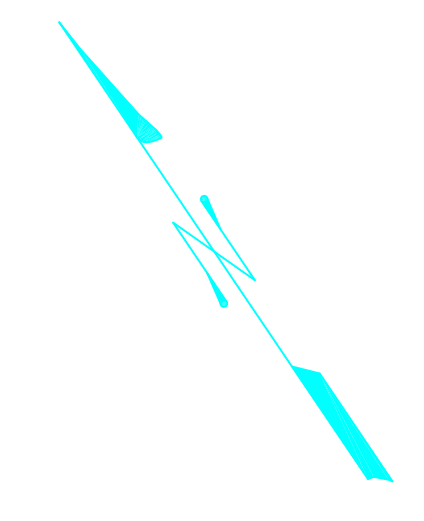

MATCHLINE STATION 15+30
SEE DWG SOM8728P004R1

MATCHLINE STATION 20+49
SEE DWG SOM8728P006R1

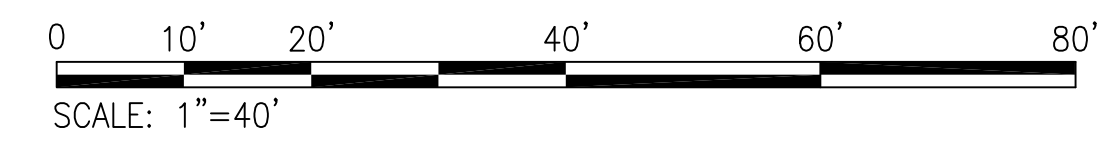

REV	DATE	DESCRIPTION	DESIGNER	CHECKED	APPROVED
1	NOV2001	AS BUILT	RM	ES	MS
2	4/22/03	Changed Level 3 reference to JTP	LM	BW	BW



SULLIVAN & MCLAUGHLIN CO.
74 LAWLEY STREET, BOSTON, MA 02122
PHONE: (617) 474-0500 FAX: (617) 474 0505

CONFIDENTIAL
FOR PROPRIETARY USE ONLY
EXCEPT AS MAY BE OTHERWISE PROVIDED
THIS DRAWING SHALL REMAIN THE PROPERTY OF
Level (3)
COMMUNICATIONS
AND SHALL NOT BE REPRODUCED, COPIED, OR USED FOR
ANY PURPOSE WITHOUT SPECIFIC WRITTEN PERMISSION.

DRAWN BY: R. MEJIA
CHECKED BY: E. SPITZER
APPROVED BY: M. SARACENO



Level (3)SM
COMMUNICATIONS

LOOP: SOMERVILLE
SEGMENT: E-3
SITE ADDRESS: McGRATH HIGHWAY
SOMERVILLE, MA

TITLE: AS-BUILT PLAN

CONTRACT NO: 8728
DRAWING NO: SOM8728P005R1
DATE DRAWN: NOV 2001
SCALE: 1" = 40'
PLOT DATE: 4/22/03

SHEET: 12 OF 19