


FOR CONTINUATION  
SEE SHEET BOS14031P001R1



REV	DATE	DESCRIPTION	DESIGNER	CHECKED	INCH
1	7/10/03	Changed Level 3 reference to JTP	LM	LM	BW

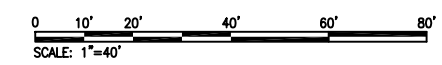

**SULLIVAN & MCLAUGHLIN CO.**  
74 LAWLEY STREET, BOSTON, MA 02122  
PHONE: (617) 474-0500 FAX: (617) 474 0505

**CONFIDENTIAL**  
FOR PROPRIETARY USE ONLY  
EXCEPT AS MAY BE OTHERWISE PROVIDED  
THIS DRAWING SHALL REMAIN THE PROPERTY OF  
**Level(3)**  
COMMUNICATIONS  
AND SHALL NOT BE REPRODUCED, COPIED, OR USED FOR  
ANY PURPOSE WITHOUT SPECIFIC WRITTEN PERMISSION.

DRAWN BY: ES  
CHECKED BY: ES  
APPROVED BY: MS

**NNTC**  
NATIONAL NETWORK TECHNOLOGIES, LLC  
65 BAY STATE DRIVE, BRAINTREE, MA 02184  
PHONE: (781) 849-3900 FAX: (781) 849-3993

**Level(3)**  
COMMUNICATIONS

LOOP: BOSTON  
SEGMENT: 1 SUMMER ST  
SITE ADDRESS: BOSTON, MA

TITLE: CHAUNCY ST

CONTRACT NO: 14031  
DRAWING NO: BOS14031P001R2  
DATE DRAWN: 7/23/02  
SCALE: 1" = 40'  
PLOT DATE: 7/23/02

SHEET: 06 OF 06