


REV	DATE	DESCRIPTION	DESIGNER	CHECKED	APP'D
1	4/24/03	Changed Level 3 reference to JTP	LM	BW	BW



**SULLIVAN & McLAUGHLIN CO.**  
 74 LAWLEY STREET, BOSTON, MA 02122  
 PHONE: (617) 474-0500 FAX: (617) 474 0505

**CONFIDENTIAL**  
 FOR PROPRIETARY USE ONLY  
 EXCEPT AS MAY BE OTHERWISE PROVIDED  
 THIS DRAWING SHALL REMAIN THE PROPERTY OF  
**Level(3)**  
 COMMUNICATIONS  
 AND SHALL NOT BE REPRODUCED, COPIED, OR USED FOR  
 ANY PURPOSE WITHOUT SPECIFIC WRITTEN PERMISSION.

DRAWN BY: R. MEJIA  
 CHECKED BY: J. DEBARROS  
 APPROVED BY: H. BERTONI

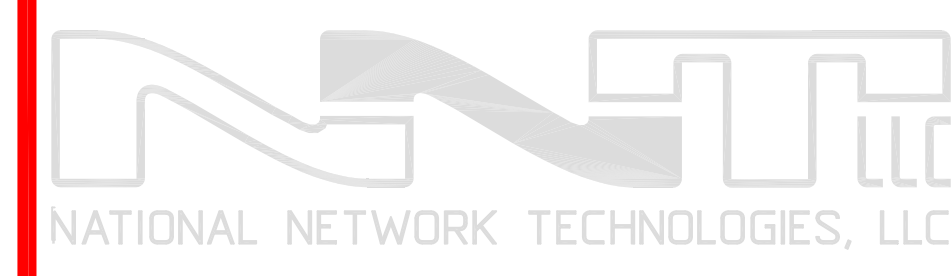

**Level(3)**<sup>SM</sup>  
 COMMUNICATIONS

LOOP: BOSTON  
 SEGMENT: A-10  
 SITE ADDRESS: BOSTON, MA

TITLE: COMMONWEALTH AVENUE

CONTRACT NO: 5977  
 DRAWING NO: BOS5977P002R1  
 DATE DRAWN: AUG2000  
 SCALE: 1" = 40'  
 PLOT DATE: 4/24/03

SHEET: 06 OF 9

