


FOR CONTINUATION SEE SEGMENT A-9D



REV	DATE	DESCRIPTION	DESIGNED	CHECKED	APPROVED
1	4/24/03	Changed Level 3 reference to JTP	LM	BW	BW

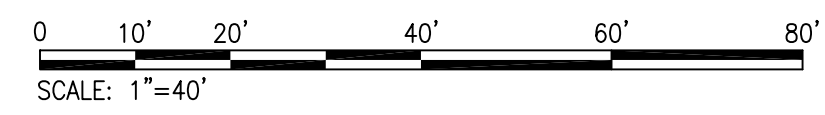

SULLIVAN & McLAUGHLIN CO.
 74 LAWLEY STREET, BOSTON, MA 02122
 PHONE: (617) 474-0500 FAX: (617) 474 0505

CONFIDENTIAL
 FOR PROPRIETARY USE ONLY
 EXCEPT AS MAY BE OTHERWISE PROVIDED
 THIS DRAWING SHALL REMAIN THE PROPERTY OF
Level(3)
 COMMUNICATIONS
 AND SHALL NOT BE REPRODUCED, COPIED, OR USED FOR
 ANY PURPOSE WITHOUT SPECIFIC WRITTEN PERMISSION.

DRAWN BY: R. MEJIA
 CHECKED BY: J. DEBARROS
 APPROVED BY: H. BERTONI



Level(3)
 COMMUNICATIONS

LOOP: BOSTON
 SEGMENT: A-10
 SITE ADDRESS: BOSTON, MA
 TITLE: COMMONWEATH AVE

CONTRACT NO: 5977
 DRAWING NO: BOS5977P005R1
 DATE DRAWN: AUG2000
 SCALE: 1" = 40'
 PLOT DATE: 4/24/03

SHEET: 09 OF 9