

REV	DATE	DESCRIPTION	BY	CHKD	APPD
1	1/16/01	AS BUILT	US	LS	
2	2/17/04	Changed Level 3 reference to JTP	LN	SP	



SULLIVAN & MCLAUGHLIN CO.
 74 LAWLEY STREET, BOSTON, MA 02122
 PHONE: (817) 474-0500 FAX: (817) 474 0505

CONFIDENTIAL
 FOR PROPRIETARY USE ONLY
 EXCEPT AS MAY BE OTHERWISE PROVIDED
 THIS DRAWING SHALL REMAIN THE PROPERTY OF
Level(3)
 COMMUNICATIONS
 AND SHALL NOT BE REPRODUCED, COPIED, OR USED FOR
 ANY PURPOSE WITHOUT SPECIFIC WRITTEN PERMISSION.

DRAWN BY: L. SCOTTO
 CHECKED BY: J. DEBARROS
 APPROVED BY: H. BERTONI


NTT
NATIONAL NETWORK TECHNOLOGIES, LLC
 65 BAY STATE DRIVE, BRAintree, MA 02184
 PHONE: (781) 849-3000 FAX: (781) 849-3093

Level(3)
 COMMUNICATIONS

LOOP: BOSTON
 SEGMENT: A-13
 SITE ADDRESS: BOSTON, MA

TITLE: HARVARD BRIDGE

CONTRACT NO: 5980	SHEET:
DRAWING NO: BOS5980P006R1	13
DATE DRAWN: SEPT2000	
SCALE: N.T.S.	
PLOT DATE: FEB. 17, 2004 10:00	
	SHEET: 13 OF 17

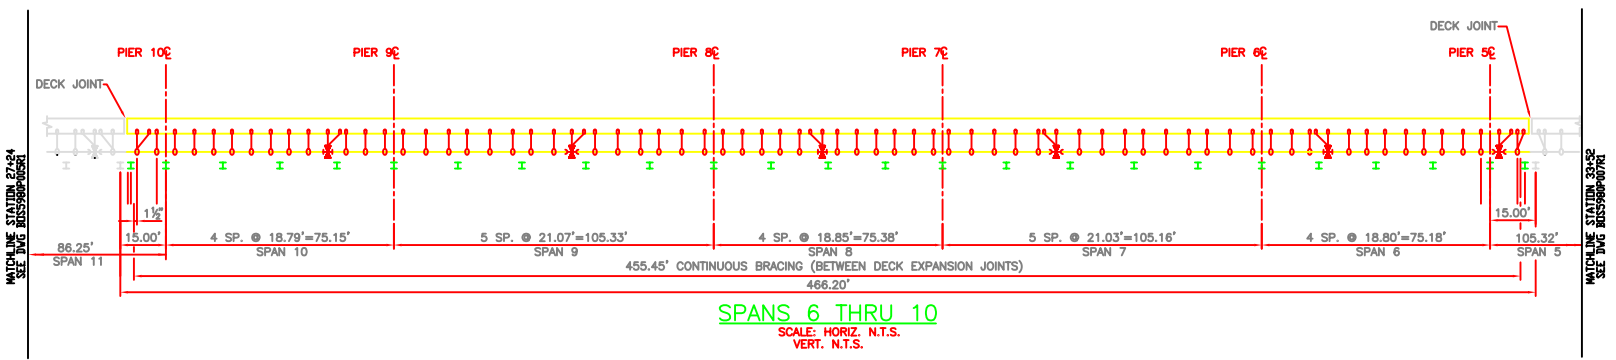

SPANS 6 THRU 10
 SCALE: HORIZ. N.T.S.
 VERT. N.T.S.

LEGEND

- ANCHOR SUPPORT WITH EXPANSION JOINT AND BRACING
- ANCHOR SUPPORT - FIXED WITH BRACING
- INTERMEDIATE SUPPORT WITH BRACING AT DECK JOINT ONLY
- INTERMEDIATE SUPPORT WITHOUT BRACING

NOTE

SCHEMATIC ELEVATION SHOWS PROPOSED CONDITIONS ON THE WEST SIDE OF THE BRIDGE.