


FRAMING PLAN
SCALE: 3/8" = 1'-0"

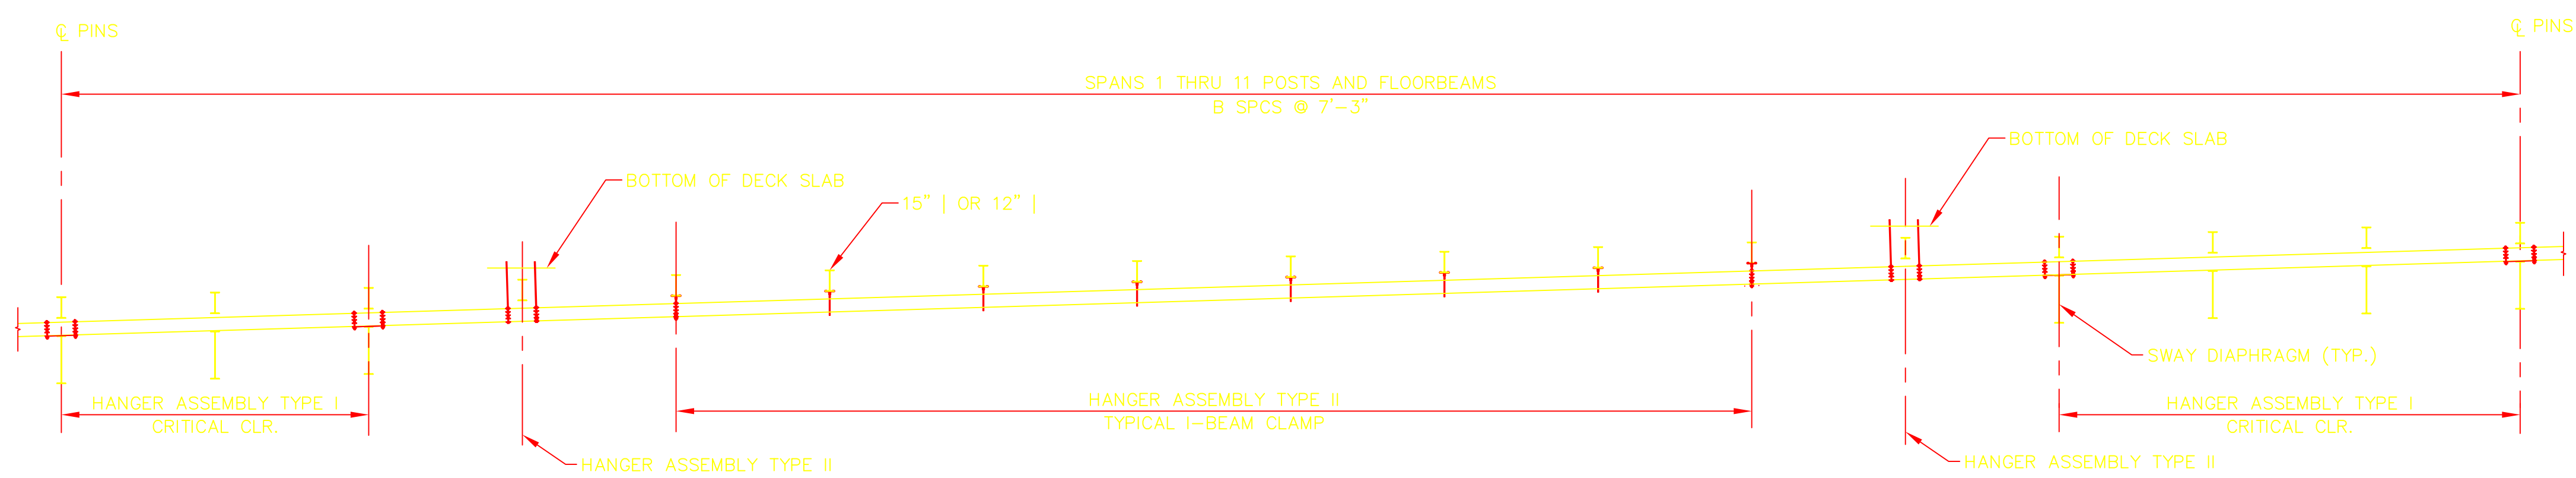

FRAMING ELEVATION
SCALE: 3/8" = 1'-0"

FRAMING SCHEDULE		
SPAN	DIM A	B SPCS
1, 11	101'-6"	14
2, 10	116'-0"	16
3, 9	130'-6"	18
4, 8	145'-0"	20
5, 7	159'-6"	22
6	188'-6"	26

CONDUIT HANGER ASSEMBLY SCHEDULE				
SPAN	BOSTON END - TYPE I	TYPE II	TYPE III	CAMBRIDGE END - TYPE I
1	0	12	0	3
2	3	10	0	4
3	4	10	0	5
4	5	10	0	6
5	6	11	0	6
6	7	8	0	5
7	6	11	0	6
8	6	10	0	5
9	5	10	0	4
10	4	10	0	3
11	0	15	0	0

REV	DATE	DESCRIPTION	DESIGNER	CHECKED	APPROVED
1	AUG2002	BUILT	ES	ES	MS
2	4/11/03	Changed Level 3 reference to JTP	LM	BW	BW



SULLIVAN & McLAUGHLIN CO.
74 LAWLEY STREET, BOSTON, MA 02122
PHONE: (617) 474-0500 FAX: (617) 474 0505

CONFIDENTIAL
FOR PROPRIETARY USE ONLY
EXCEPT AS MAY BE OTHERWISE PROVIDED
THIS DRAWING SHALL REMAIN THE PROPERTY OF
Level(3)
COMMUNICATIONS
AND SHALL NOT BE REPRODUCED, COPIED, OR USED FOR
ANY PURPOSE WITHOUT SPECIFIC WRITTEN PERMISSION.

DRAWN BY: ES
CHECKED BY: ES
APPROVED BY: MS



Level(3)
COMMUNICATIONS

LOOP: BOSTON

SEGMENT: A-5

SITE ADDRESS: BOSTON, MA

TITLE: FRAMING PLAN & CONDUIT HANGER ASSEMBLY SCHEDULE

CONTRACT NO: 5989

DRAWING NO: BOS5989P001R1

DATE DRAWN: AUG 2002

SCALE: N.T.S.

PLOT DATE: APR 11, 2003

SHEET:

17

SHEET: 17 OF: 21