

| REV | DATE | DESCRIPTION | DESIGNER | CHECKED | APPROVED |
|-----|---------|----------------------------------|----------|---------|----------|
| 1 | AUG2002 | AS BUILT | ES | ES | MS |
| 2 | 4/11/03 | Changed Level 3 reference to JTP | LM | BW | BW |
| | | | | | |
| | | | | | |
| | | | | | |



SULLIVAN & MCLAUGHLIN CO.
 74 LAWLEY STREET, BOSTON, MA 02122
 PHONE: (617) 474-0500 FAX: (617) 474 0505

CONFIDENTIAL
 FOR PROPRIETARY USE ONLY
 EXCEPT AS MAY BE OTHERWISE PROVIDED
 THIS DRAWING SHALL REMAIN THE PROPERTY OF
Level(3)
 COMMUNICATIONS
 AND SHALL NOT BE REPRODUCED, COPIED, OR USED FOR
 ANY PURPOSE WITHOUT SPECIFIC WRITTEN PERMISSION.

DRAWN BY: ES
 CHECKED BY: ES
 APPROVED BY: MS




Level(3)SM
 COMMUNICATIONS

LOOP: BOSTON
 SEGMENT: A-5
 SITE ADDRESS: BOSTON, MA


TITLE: INNER DUCT INSTALLATION
 CAMBRIDGE ABUTMENT

CONTRACT NO: 5989
 DRAWING NO: BOS5989P002R1
 DATE DRAWN: AUG 2002
 SCALE: N.T.S.
 PLOT DATE: APR 11, 2003

SHEET: 18 OF 21

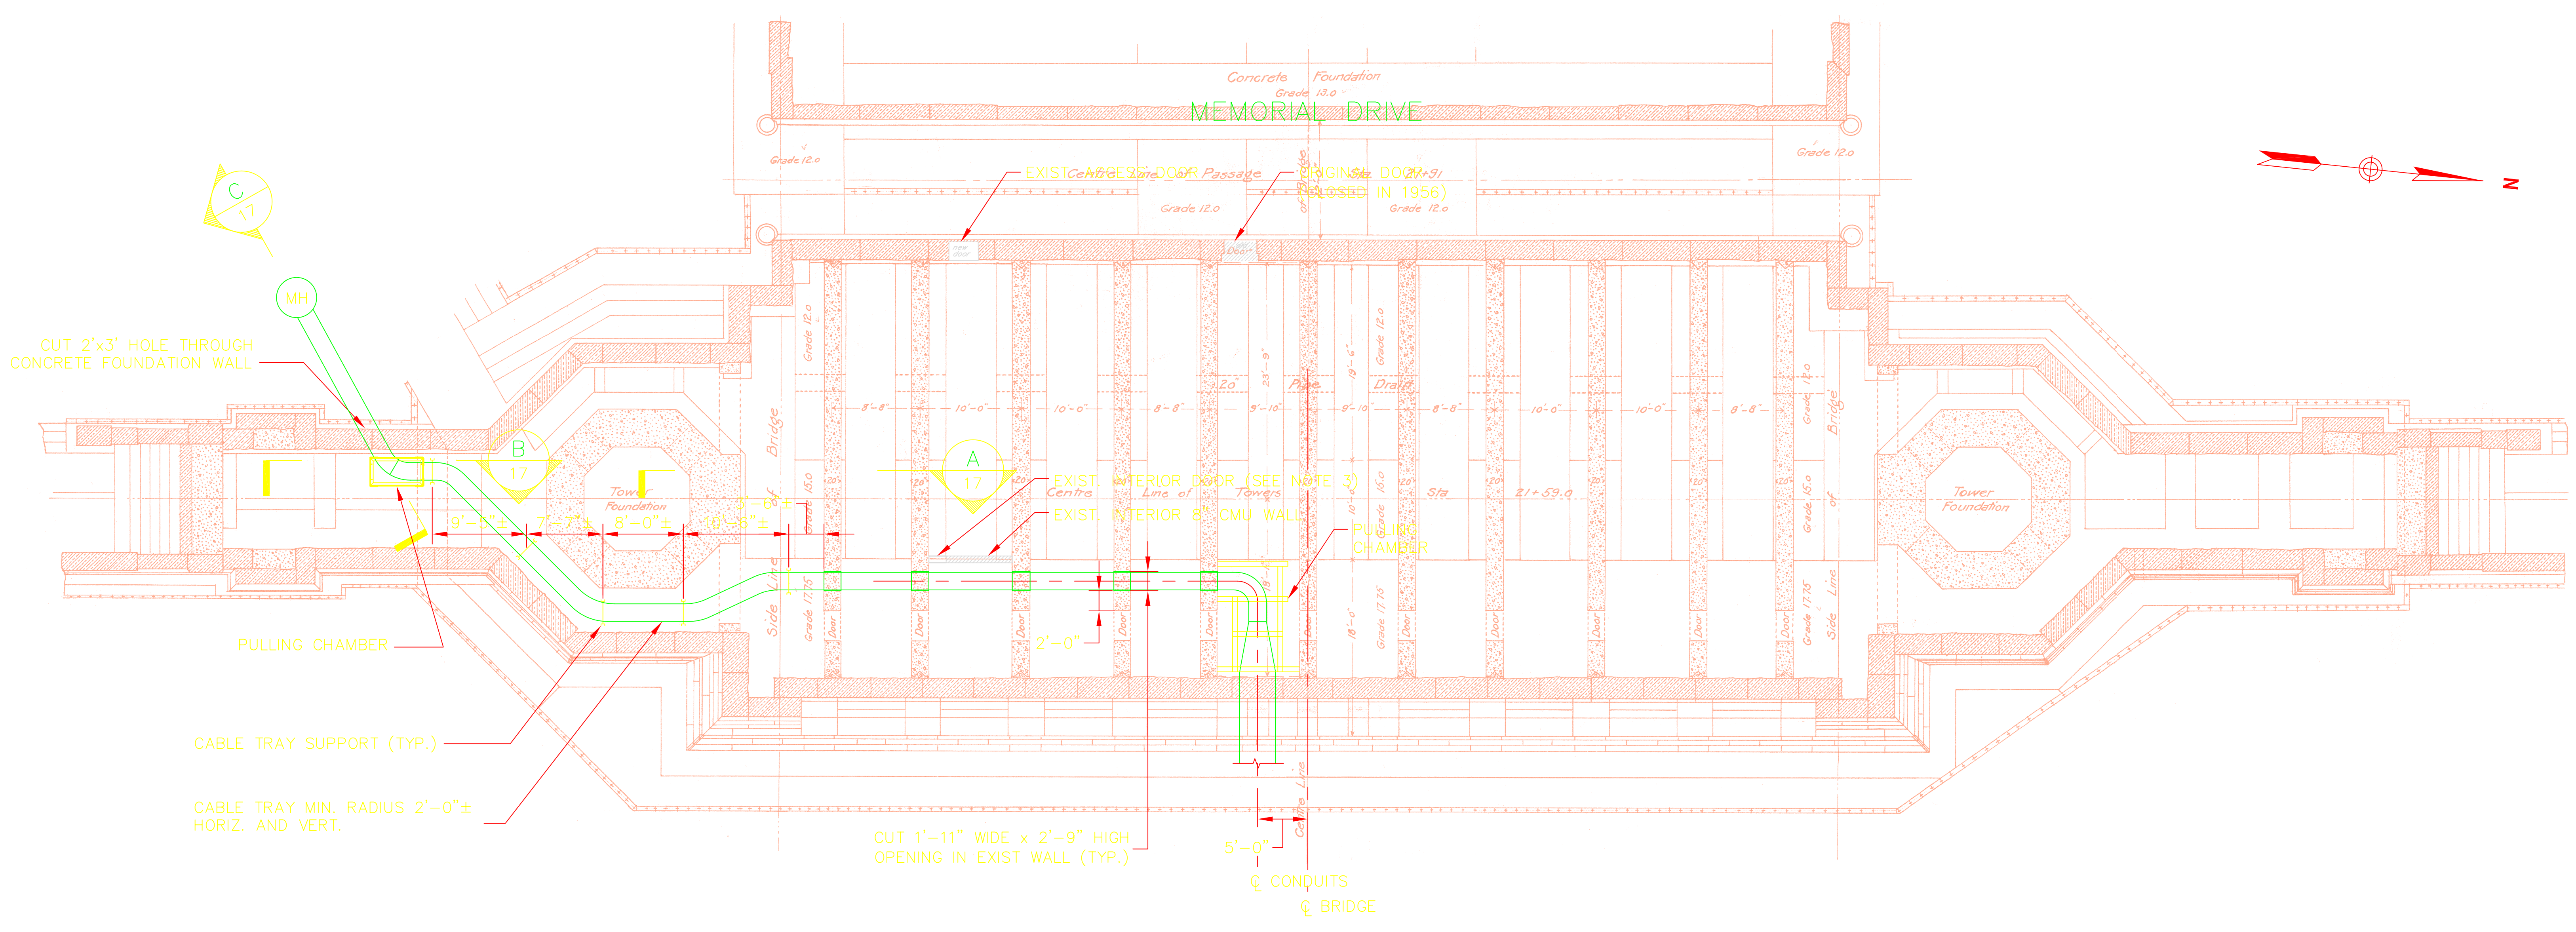

PLAN-CAMBRIDGE ABUTMENT
 SCALE: 1"=10'-0"

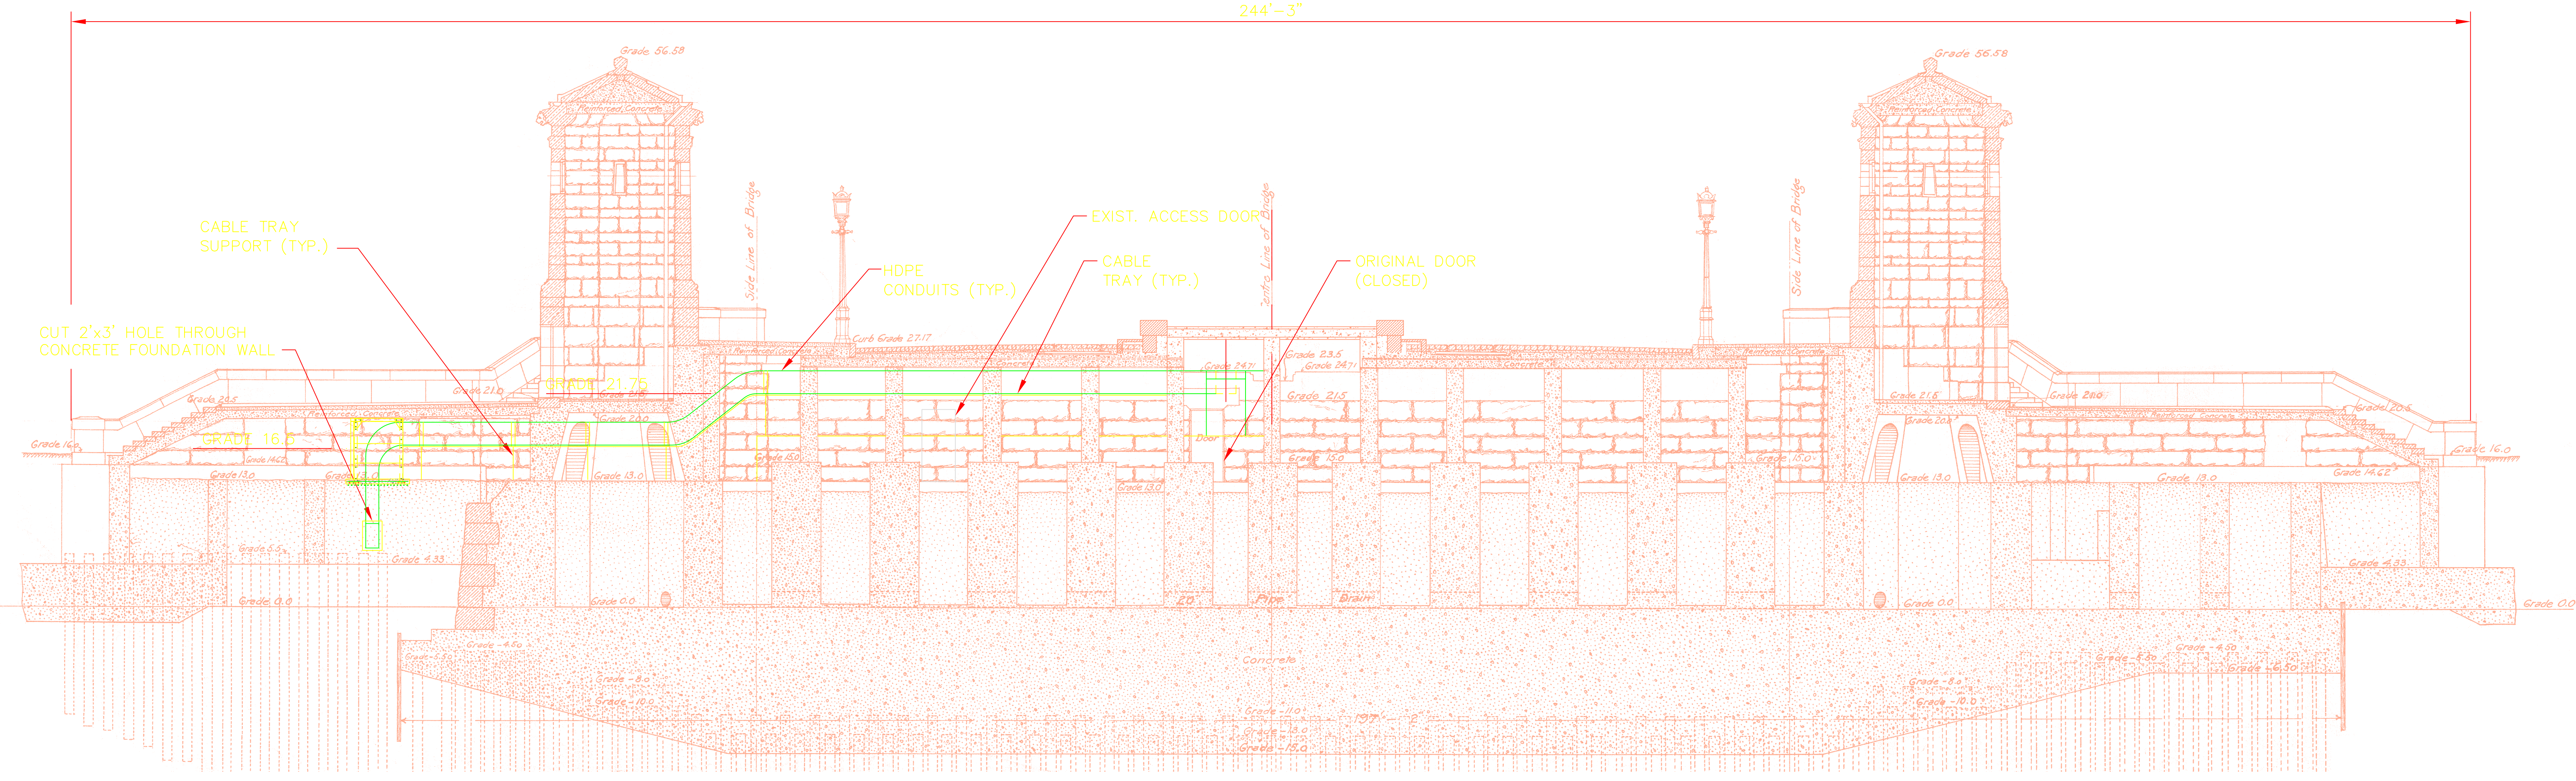

ELEVATION-CAMBRIDGE ABUTMENT
 SCALE: 1"=10'-0"