

REV	DATE	DESCRIPTION	DESIGNER	CHECKED	APPROVED
1	AUG2002	AS BUILT	ES	ES	MS
2	4/11/03	Changed Level 3 reference to JTP	LM	BW	BW



SULLIVAN & MCLAUGHLIN CO.
 74 LAWLEY STREET, BOSTON, MA 02122
 PHONE: (617) 474-0500 FAX: (617) 474 0505

CONFIDENTIAL
 FOR PROPRIETARY USE ONLY
 EXCEPT AS MAY BE OTHERWISE PROVIDED
 THIS DRAWING SHALL REMAIN THE PROPERTY OF
Level(3)
 COMMUNICATIONS
 AND SHALL NOT BE REPRODUCED, COPIED, OR USED FOR
 ANY PURPOSE WITHOUT SPECIFIC WRITTEN PERMISSION.

DRAWN BY: ES
 CHECKED BY: ES
 APPROVED BY: MS




Level(3)SM
 COMMUNICATIONS

LOOP: BOSTON
 SEGMENT: A-5
 SITE ADDRESS: BOSTON, MA


TITLE: INNER DUCT INSTALLATION
 BOSTON ABUTMENT

CONTRACT NO: 5989
 DRAWING NO: BOS5989P003R1
 DATE DRAWN: AUG 2002
 SCALE: N.T.S.
 PLOT DATE: APR 11, 2003

SHEET: 19 OF 21

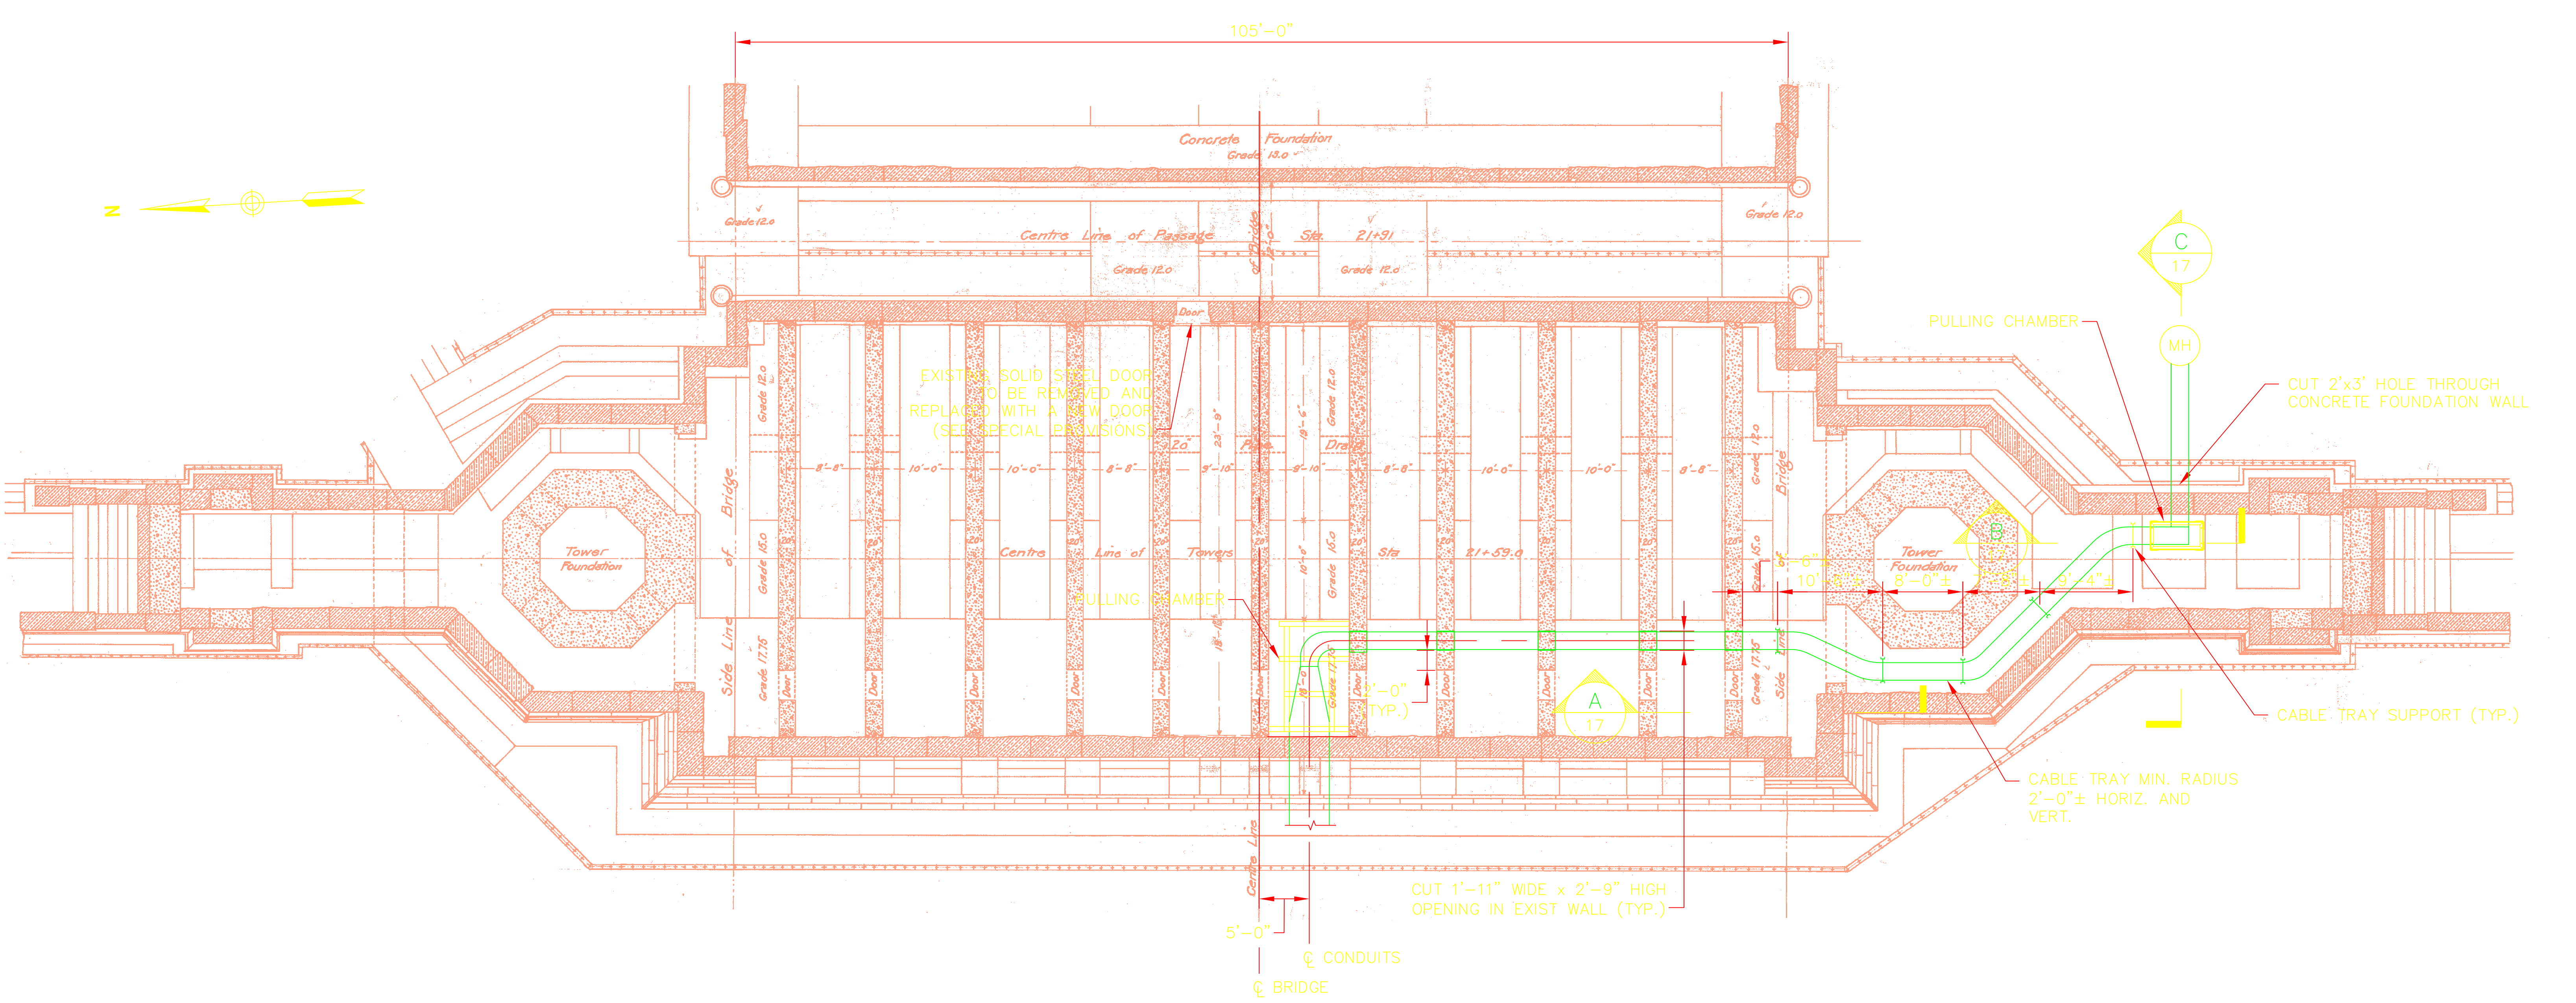

PLAN-BOSTON ABUTMENT
 SCALE: 1"=10'-0"

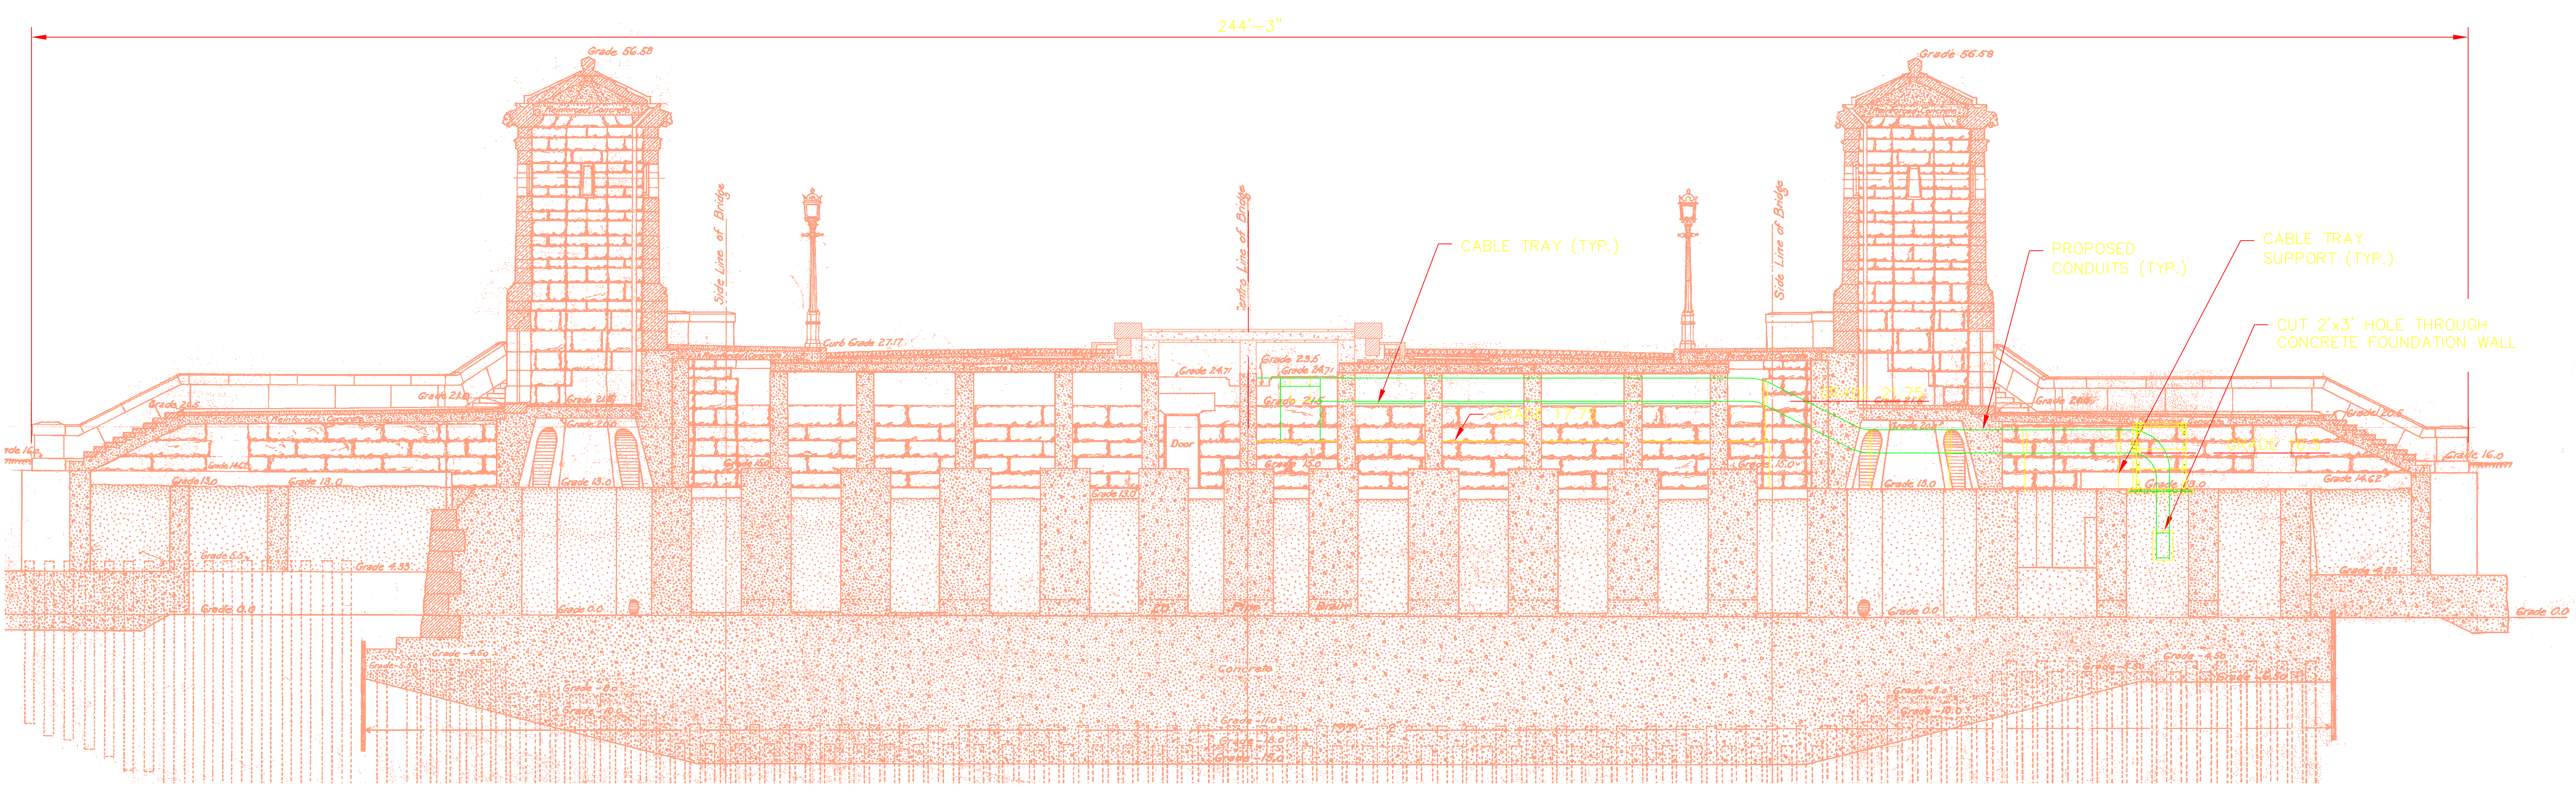

ELEVATION-BOSTON ABUTMENT
 SCALE: 1"=10'-0"