


MATCHLINE STATION 4+26
SEE DWG BOS5990P001R1

MATCHLINE STATION 9+36
SEE DWG BOS5990P003R1

BURIED WITH MIN 15"
OF COVER UNLESS
OTHERWISE SPECIFIED

JTP 98-1 1/4" PATHWAYS
3-4" PATHWAY CONDUIT

813' LF-c/c

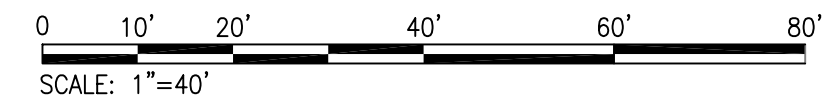

REV	DATE	DESCRIPTION	DESIGNER	CHECKED	APPROVED
1	4/11/03	Changed Level 3 reference to JTP	LM	BW	BW



SULLIVAN & McLAUGHLIN CO.
74 LAWLEY STREET, BOSTON, MA 02122
PHONE: (617) 474-0500 FAX: (617) 474 0505

CONFIDENTIAL
FOR PROPRIETARY USE ONLY
EXCEPT AS MAY BE OTHERWISE PROVIDED
THIS DRAWING SHALL REMAIN THE PROPERTY OF
Level(3)
COMMUNICATIONS
AND SHALL NOT BE REPRODUCED, COPIED, OR USED FOR
ANY PURPOSE WITHOUT SPECIFIC WRITTEN PERMISSION.

DRAWN BY: MLS
CHECKED BY: ES
APPROVED BY: MS



Level(3)
COMMUNICATIONS

LOOP: BOSTON
SEGMENT: A-6
SITE ADDRESS: BOSTON, MA
TITLE: CAMBRIDGE STREET

CONTRACT NO: 5990
DRAWING NO: BOS5990P002R1
DATE DRAWN: 08/25/01
SCALE: 1" = 40'
PLOT DATE: 04/11/03

SHEET: 06 OF 11