

REV	DATE	DESCRIPTION	DESIGNER	CHECKED	APP'D
1	NOV2001	AS BUILT	E.S.	E.S.	P.C.
2	4/11/03	Changed Level 3 reference to JTP	JLM	EW	EW




**SULLIVAN & MCLAUGHLIN CO.**

74 LAWLEY STREET, BOSTON, MA 02122  
 PHONE: (617) 474-0500 FAX: (617) 474 0505

**CONFIDENTIAL**  
 FOR PROPRIETARY USE ONLY  
 EXCEPT AS MAY BE OTHERWISE PROVIDED  
 THIS DRAWING SHALL REMAIN THE PROPERTY OF  
**Level(3)**  
 COMMUNICATIONS  
 AND SHALL NOT BE REPRODUCED, COPIED, OR USED FOR  
 ANY PURPOSE WITHOUT SPECIFIC WRITTEN PERMISSION.

DRAWN BY: E.S.  
 CHECKED BY: E.S.  
 APPROVED BY: P.C.

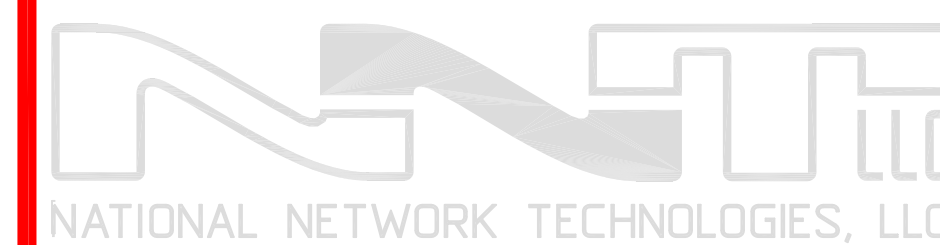

LOOP: BOSTON  
 SEGMENT: A-7  
 SITE ADDRESS: BOSTON, MA

TITLE: CONGRESS ST. & HIGH ST.

CONTRACT NO: 5991  
 DRAWING NO: BOS5991P011R1  
 DATE DRAWN: 11/08/02  
 SCALE: 1" = 40'  
 PLOT DATE: 4/11/03

SHEET: 15 OF 21

