


REV	DATE	DESCRIPTION	DESIGNER	CHECKED	APPROVED
1	NOV2001	AS BUILT	E.S.	E.S.	P.C.
2	4/11/03	Changed Level 3 reference to JTP	LM	BW	BW



SULLIVAN & MCLAUGHLIN CO.
 74 LAWLEY STREET, BOSTON, MA 02122
 PHONE: (617) 474-0500 FAX: (617) 474 0505

CONFIDENTIAL
 FOR PROPRIETARY USE ONLY
 EXCEPT AS MAY BE OTHERWISE PROVIDED
 THIS DRAWING SHALL REMAIN THE PROPERTY OF
Level(3)
 COMMUNICATIONS
 AND SHALL NOT BE REPRODUCED, COPIED, OR USED FOR
 ANY PURPOSE WITHOUT SPECIFIC WRITTEN PERMISSION.



DRAWN BY: E.S.
 CHECKED BY: E.S.
 APPROVED BY: P.C.

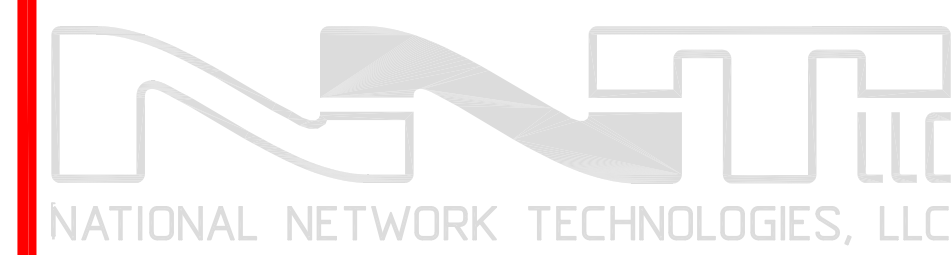

Level(3)SM
 COMMUNICATIONS

LOOP: BOSTON
 SEGMENT: A-7
 SITE ADDRESS: BOSTON, MA
 TITLE: HIGH ST.

CONTRACT NO: 5991 SHEET:
 DRAWING NO: BOS5991P012R1
 DATE DRAWN: 11/08/02
 SCALE: 1" = 40'
 PLOT DATE: 4/11/03 SHEET: 16 OF: 21

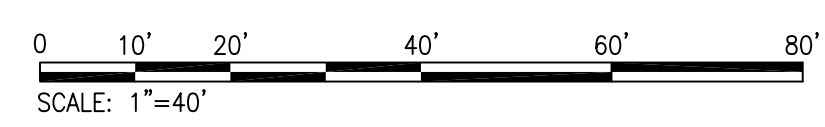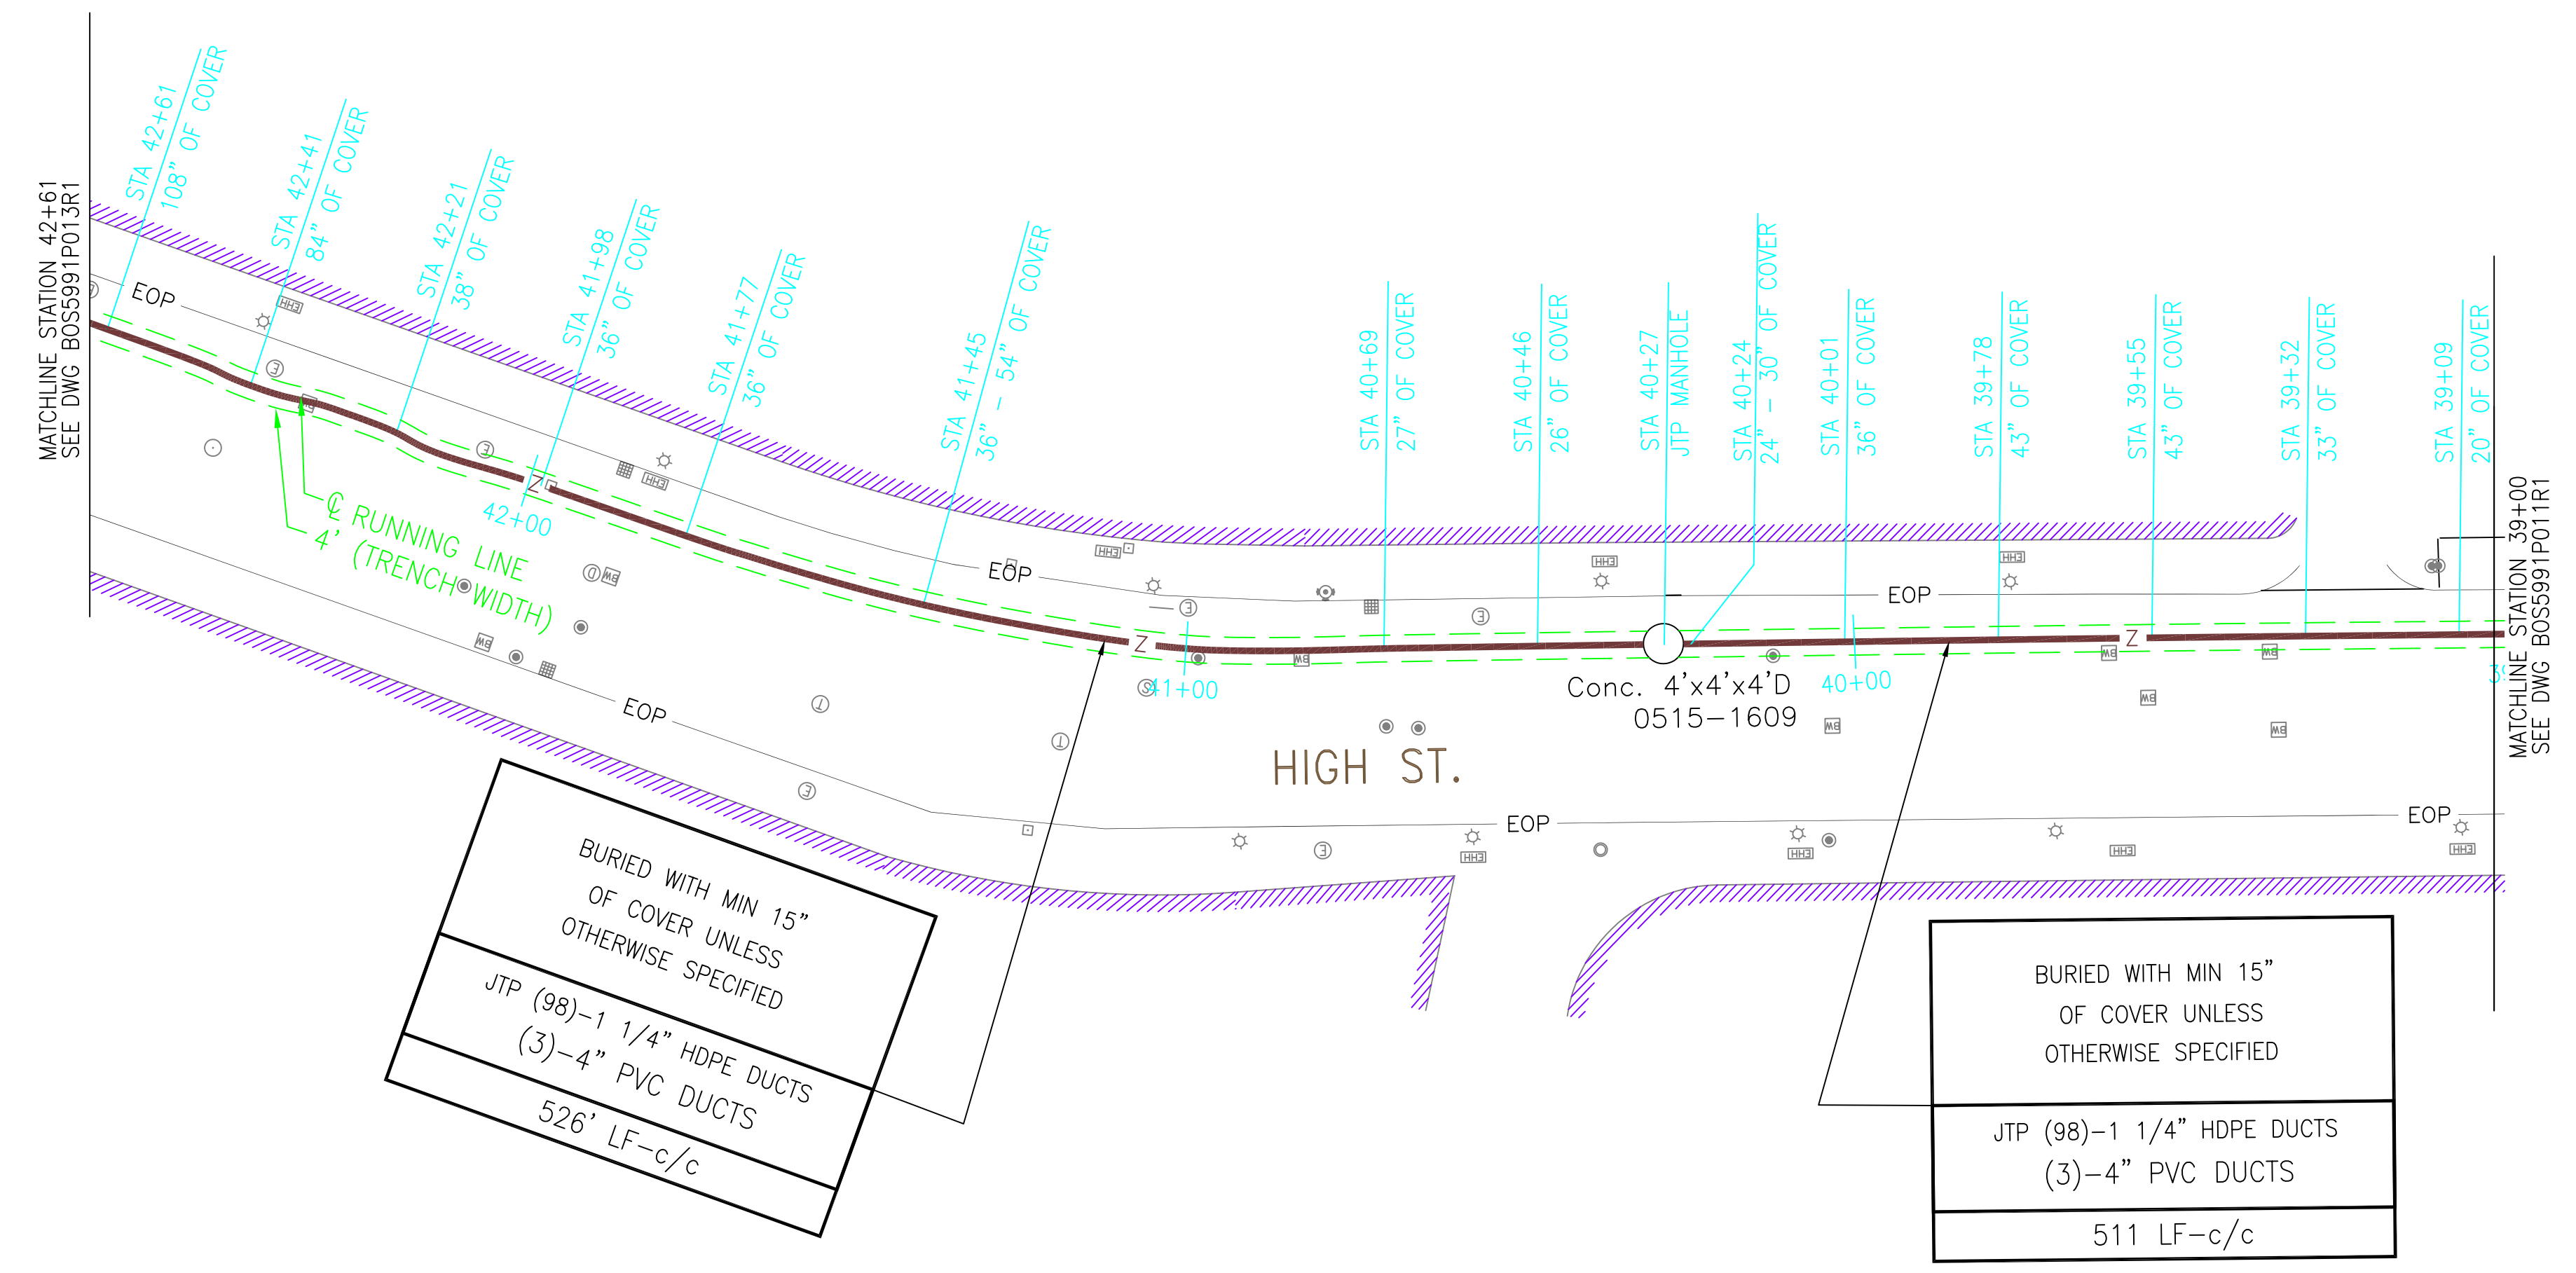

16