


BURIED WITH MIN 15" OF COVER UNLESS OTHERWISE SPECIFIED

JTP (98)-1 1/4" HDPE DUCTS
(3)-4" PVC DUCTS

526' LF-c/c

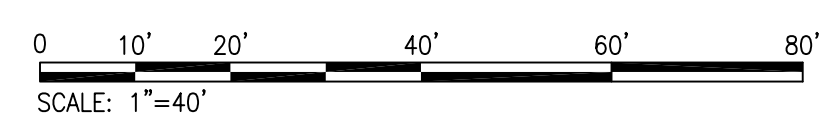


REV	DATE	DESCRIPTION	DESIGNER	CHECKED	APPROVED
1	NOV2001	AS BUILT	E.S.	E.S.	P.C.
2	4/11/03	Changed Level 3 reference to JTP	LM	BW	BW



SULLIVAN & MCLAUGHLIN CO.
74 LAWLEY STREET, BOSTON, MA 02122
PHONE: (617) 474-0500 FAX: (617) 474 0505

CONFIDENTIAL
FOR PROPRIETARY USE ONLY
EXCEPT AS MAY BE OTHERWISE PROVIDED
THIS DRAWING SHALL REMAIN THE PROPERTY OF
Level(3)
COMMUNICATIONS
AND SHALL NOT BE REPRODUCED, COPIED, OR USED FOR ANY PURPOSE WITHOUT SPECIFIC WRITTEN PERMISSION.

DRAWN BY: E.S.
CHECKED BY: E.S.
APPROVED BY: P.C.

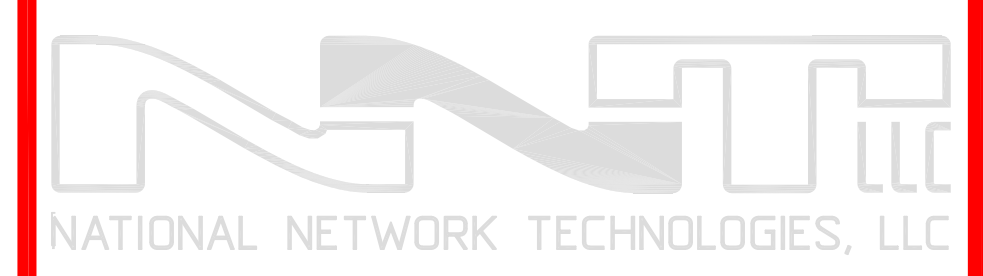

Level(3)
COMMUNICATIONS

LOOP: BOSTON

SEGMENT: A-7

SITE ADDRESS: BOSTON, MA

TITLE: HIGH ST.

CONTRACT NO: 5991
DRAWING NO: BOS5991P013R1
DATE DRAWN: 11/08/02
SCALE: 1" = 40'
PLOT DATE: 4/11/03

SHEET: 17 OF 21