


REV	DATE	DESCRIPTION	DESIGNER	CHECKED	APPROVED
1	NOV2001	AS BUILT	E.S.	E.S.	P.C.
2	4/11/03	Changed Level 3 reference to JTP	LM	BW	BW



**SULLIVAN & McLAUGHLIN CO.**  
74 LAWLEY STREET, BOSTON, MA 02122  
PHONE: (617) 474-0500 FAX: (617) 474 0505

**CONFIDENTIAL**  
FOR PROPRIETARY USE ONLY  
EXCEPT AS MAY BE OTHERWISE PROVIDED  
THIS DRAWING SHALL REMAIN THE PROPERTY OF  
**Level(3)**  
COMMUNICATIONS  
AND SHALL NOT BE REPRODUCED, COPIED, OR USED FOR  
ANY PURPOSE WITHOUT SPECIFIC WRITTEN PERMISSION.

DRAWN BY: E.S.  
CHECKED BY: E.S.  
APPROVED BY: P.C.

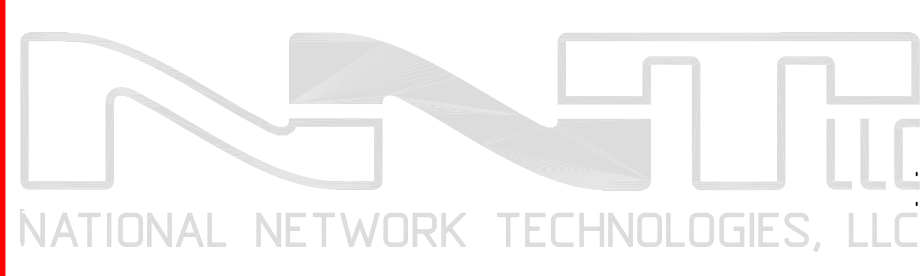

**Level(3)**<sup>SM</sup>  
COMMUNICATIONS

LOOP: BOSTON

SEGMENT: A-7

SITE ADDRESS:  
BOSTON, MA

TITLE:  
SUMMER ST.

CONTRACT NO: 5991  
DRAWING NO: BOS5991P014R1  
DATE DRAWN: 11/08/02  
SCALE: 1" = 40'  
PLOT DATE: 4/11/03

SHEET:  
**18**  
SHEET: 18 OF: 21