

REV	DATE	DESCRIPTION	DESIGNER	CHECKED	APPROVED
1	JAN2002	AS-BUILT	LM	MS	ES
2	4/14/03	Changed Level 3 reference to JTP	LM	BW	BW




**SULLIVAN & McLAUGHLIN CO.**  
 74 LAWLEY STREET, BOSTON, MA 02122  
 PHONE: (617) 474-0500 FAX: (617) 474 0505

**CONFIDENTIAL**  
 FOR PROPRIETARY USE ONLY  
 EXCEPT AS MAY BE OTHERWISE PROVIDED  
 THIS DRAWING SHALL REMAIN THE PROPERTY OF  
**Level(3)**  
 COMMUNICATIONS  
 AND SHALL NOT BE REPRODUCED, COPIED, OR USED FOR  
 ANY PURPOSE WITHOUT SPECIFIC WRITTEN PERMISSION.

DRAWN BY: R. MEJIA

CHECKED BY: M. SARACENO

APPROVED BY: E. SPITZER

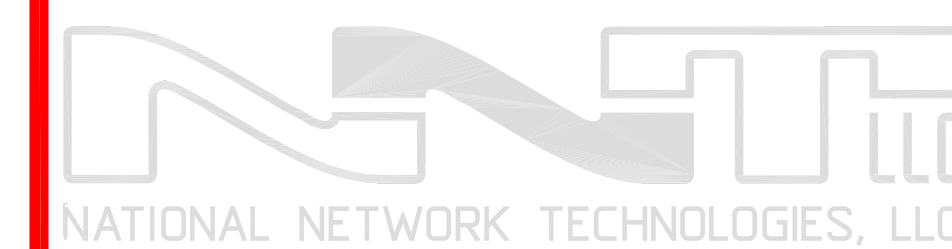

LOOP: BOSTON

SEGMENT: A-8B

SITE ADDRESS: CHARLES STREET  
 BOSTON, MA

TITLE: AS-BUILT PLAN

CONTRACT NO: 5993

DRAWING NO: BOS5993P001R1

DATE DRAWN: FEB2002


SCALE: 1" = 40'

PLOT DATE: 4/14/03

SHEET:

05

SHEET: 05 OF: 06

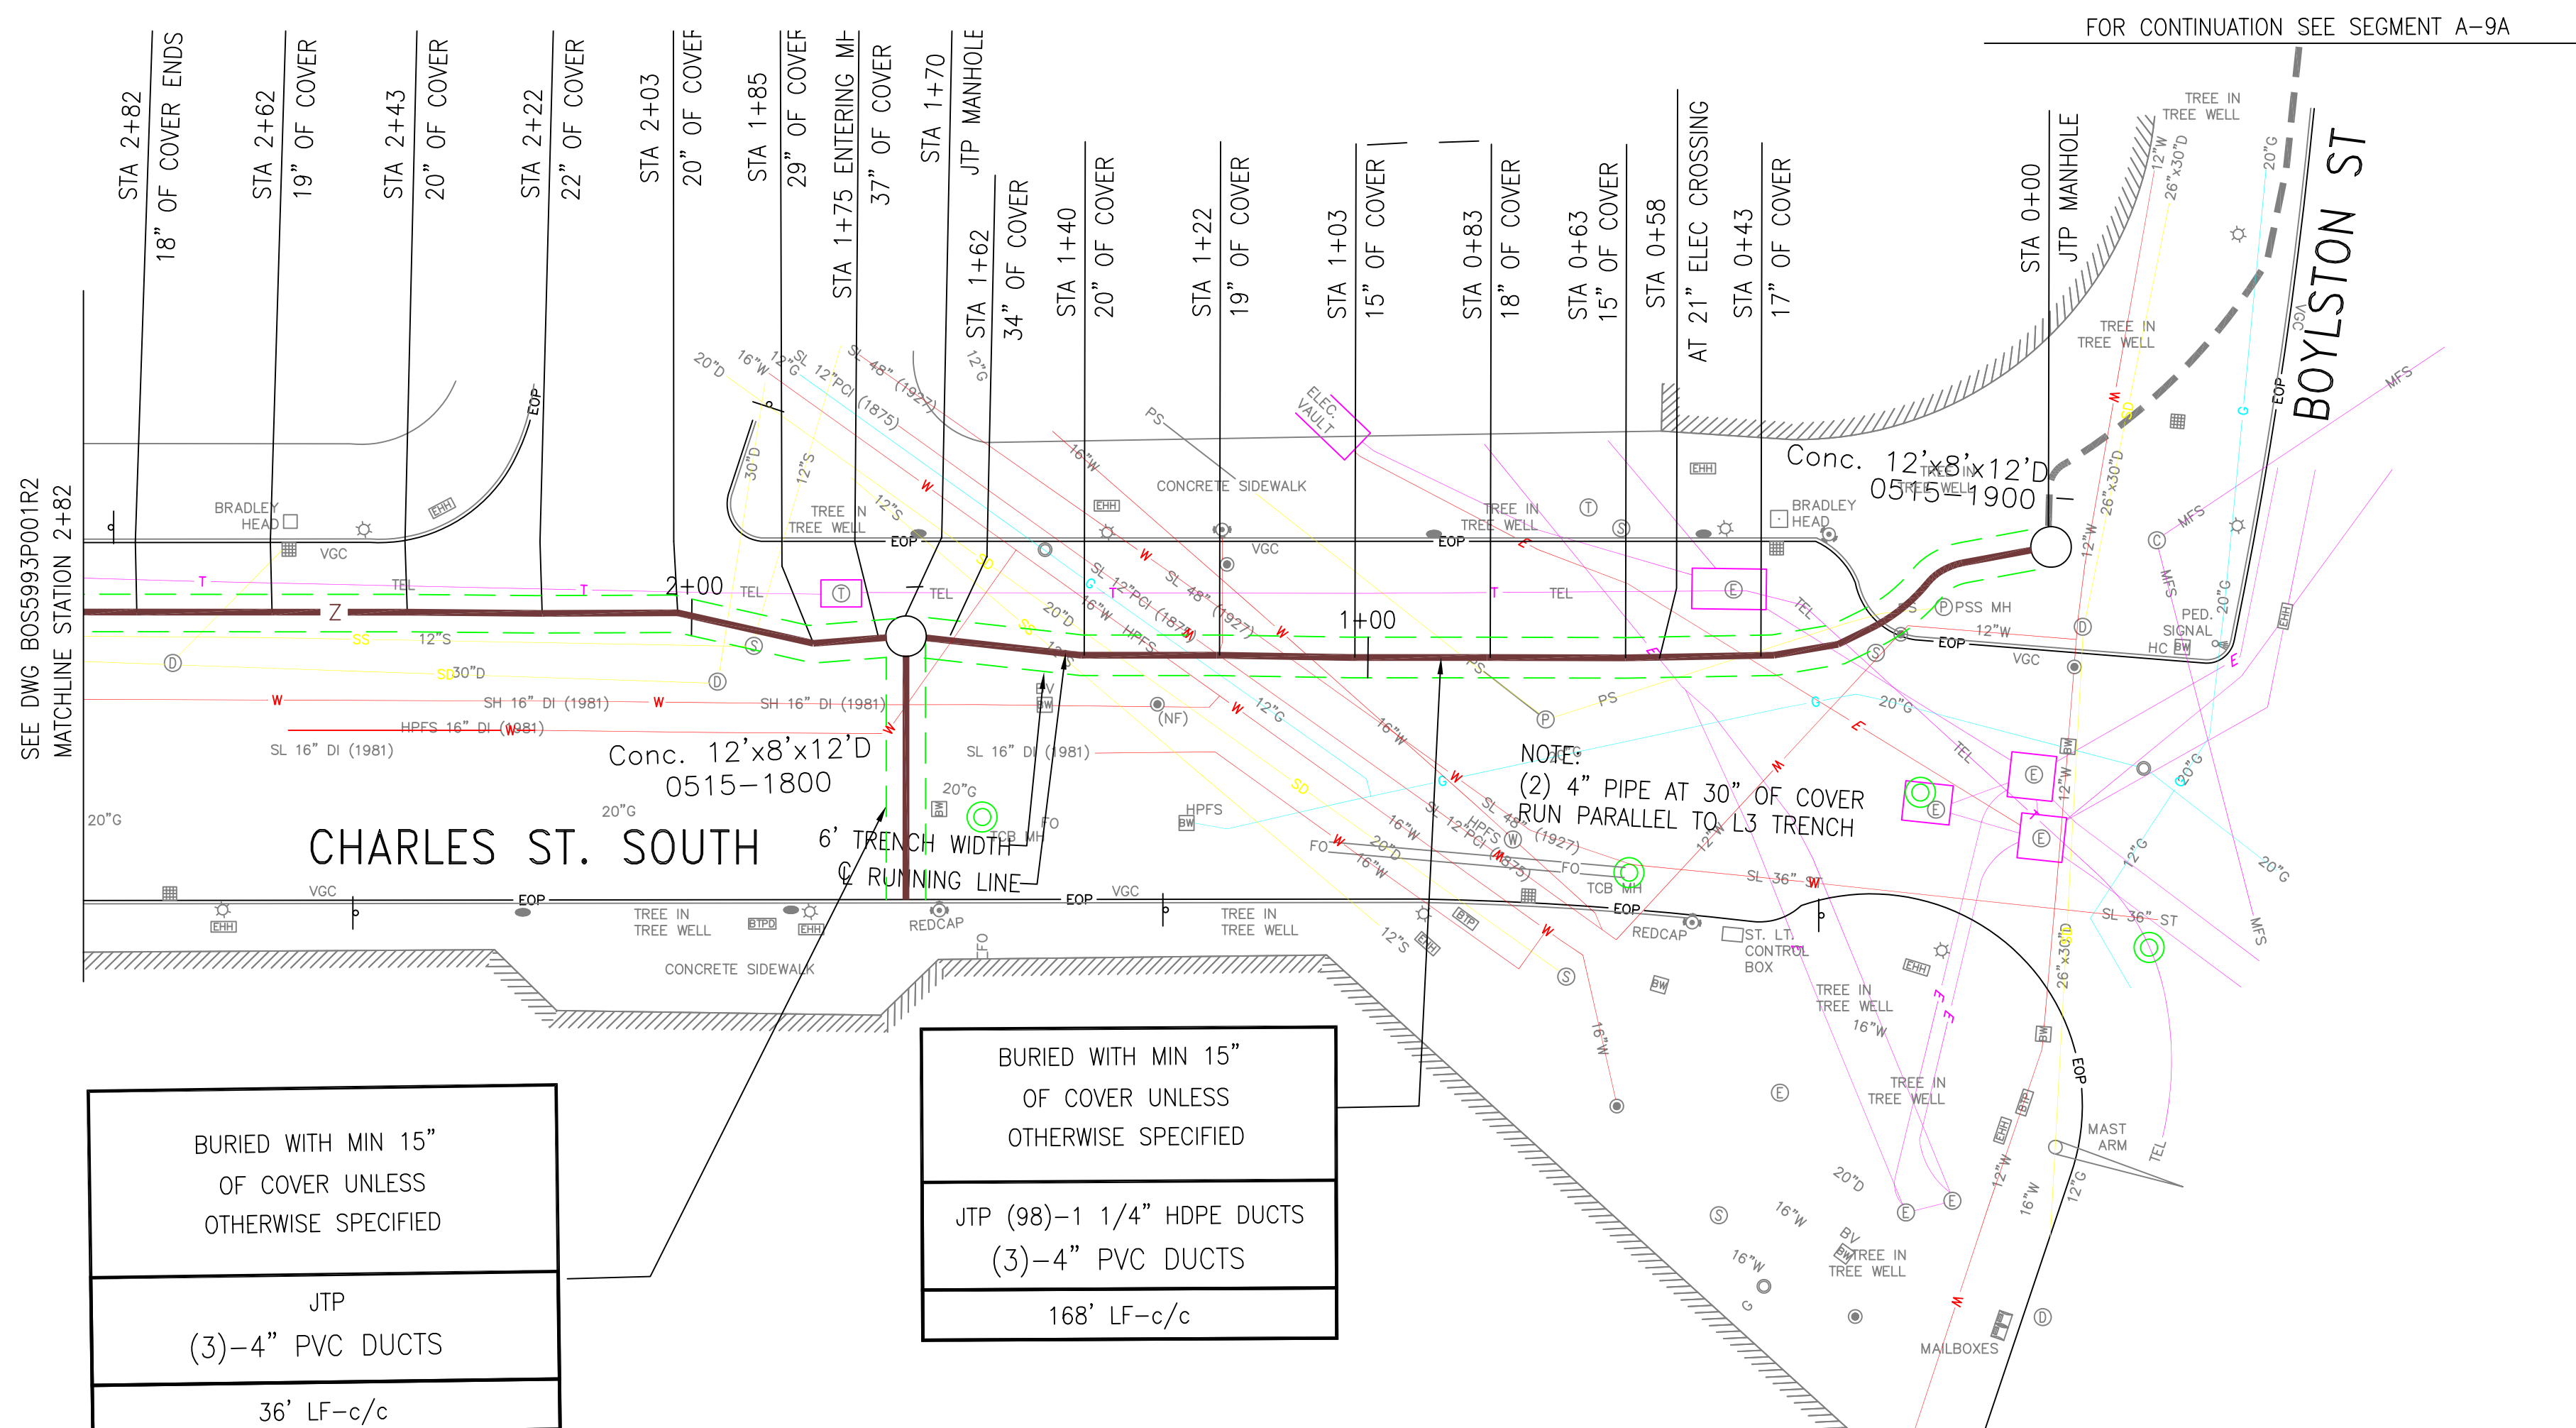

BURIED WITH MIN 15"  
 OF COVER UNLESS  
 OTHERWISE SPECIFIED

JTP  
 (3)-4" PVC DUCTS  
 36' LF-c/c

BURIED WITH MIN 15"  
 OF COVER UNLESS  
 OTHERWISE SPECIFIED

JTP (98)-1 1/4" HDPE DUCTS  
 (3)-4" PVC DUCTS  
 168' LF-c/c

