


OF COVER UNLESS OTHERWISE SPECIFIED

JTP (98)-1 1/4" HDPE DUCTS  
(3)-4" PVC DUCTS

353' LF--c/c

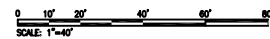

REV	DATE	DESCRIPTION	BY	CHKD	APPD
1	JAN2002	AS-BUILT	RM	MS	ES
2	4/14/03	Changed Level 3 reference to JTP	LM	RM	BM



**SULLIVAN & McLAUGHLIN CO.**  
 74 LAWLEY STREET, BOSTON, MA 02122  
 PHONE: (617) 474-0500 FAX: (617) 474 0505

**CONFIDENTIAL**  
 FOR PROPRIETARY USE ONLY  
 EXCEPT AS MAY BE OTHERWISE PROVIDED  
 THIS DRAWING SHALL REMAIN THE PROPERTY OF  
**Level(3)**  
 COMMUNICATIONS  
 AND SHALL NOT BE REPRODUCED, COPIED, OR USED FOR ANY PURPOSE WITHOUT SPECIFIC WRITTEN PERMISSION.

**DRAWN BY:** R. MEJIA  
**CHECKED BY:** M. SARACENO  
**APPROVED BY:** E. SPITZER



**Level(3)**  
 COMMUNICATIONS

**LOOP:** BOSTON  
**SEGMENT:** A-88  
**SITE ADDRESS:** CHARLES STREET  
 BOSTON, MA

**TITLE:** AS-BUILT PLAN

<b>CONTRACT NO.:</b> 5993	<b>SHEET:</b>  <b>06</b>
<b>DRAWING NO.:</b> BOSS593P001R2	
<b>DATE DRAWN:</b> FEB2002	
<b>SCALE:</b> 1" = 40'	
<b>PLLOT DATE:</b> 4/14/03	<b>SHEET: 06 OF: 06</b>