


FOR CONTINUATION SEE SEGMENT A-9B

MATCHLINE STATION 4+90
SEE DWG CAM5994P002R2



REV	DATE	DESCRIPTION	DESIGN	CHECK	APPD
1	MAR2001	AS BUILT	RM	JB	TJB
2	08/2001	AS BUILT (LATERAL)	RM	JB	TJB
3	4/14/03	Changed Level 3 reference to JTP	LM	EW	EW

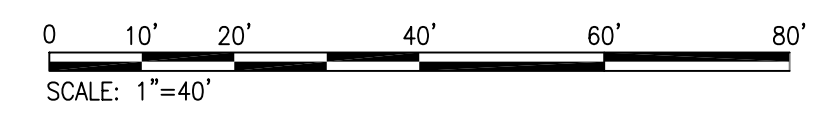

SULLIVAN & MCLAUGHLIN CO.
74 LAWLEY STREET, BOSTON, MA 02122
PHONE: (617) 474-0500 FAX: (617) 474 0505

CONFIDENTIAL
FOR PROPRIETARY USE ONLY
EXCEPT AS MAY BE OTHERWISE PROVIDED
THIS DRAWING SHALL REMAIN THE PROPERTY OF
Level(3)
COMMUNICATIONS
AND SHALL NOT BE REPRODUCED, COPIED, OR USED FOR
ANY PURPOSE WITHOUT SPECIFIC WRITTEN PERMISSION.

DRAWN BY: R. MEJIA
CHECKED BY: J. DEBARROS
APPROVED BY: H. BERTONI



Level(3)SM
COMMUNICATIONS

LOOP: BOSTON
SEGMENT: A-9A
SITE ADDRESS: BOSTON, MA

TITLE: BOYLSTON STREET

CONTRACT NO: 5994
DRAWING NO: BOS5994P001R2
DATE DRAWN: NOV2000
SCALE: 1" = 40'
PLOT DATE: 4/14/03

SHEET: 5 OF: 14

05