
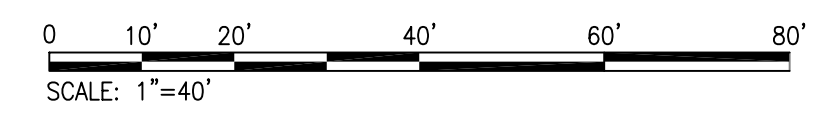


MATCHLINE STATION 4+80
SEE DWG CAM5994P001R2

MATCHLINE STATION 10+39
SEE DWG CAM5994P003R2

BURIED WITH MIN 15"
OF COVER UNLESS
OTHERWISE SPECIFIED

JTP (98)-1 1/4" HDPE DUCTS
(3)-4" PVC DUCTS
641' LF-c/c

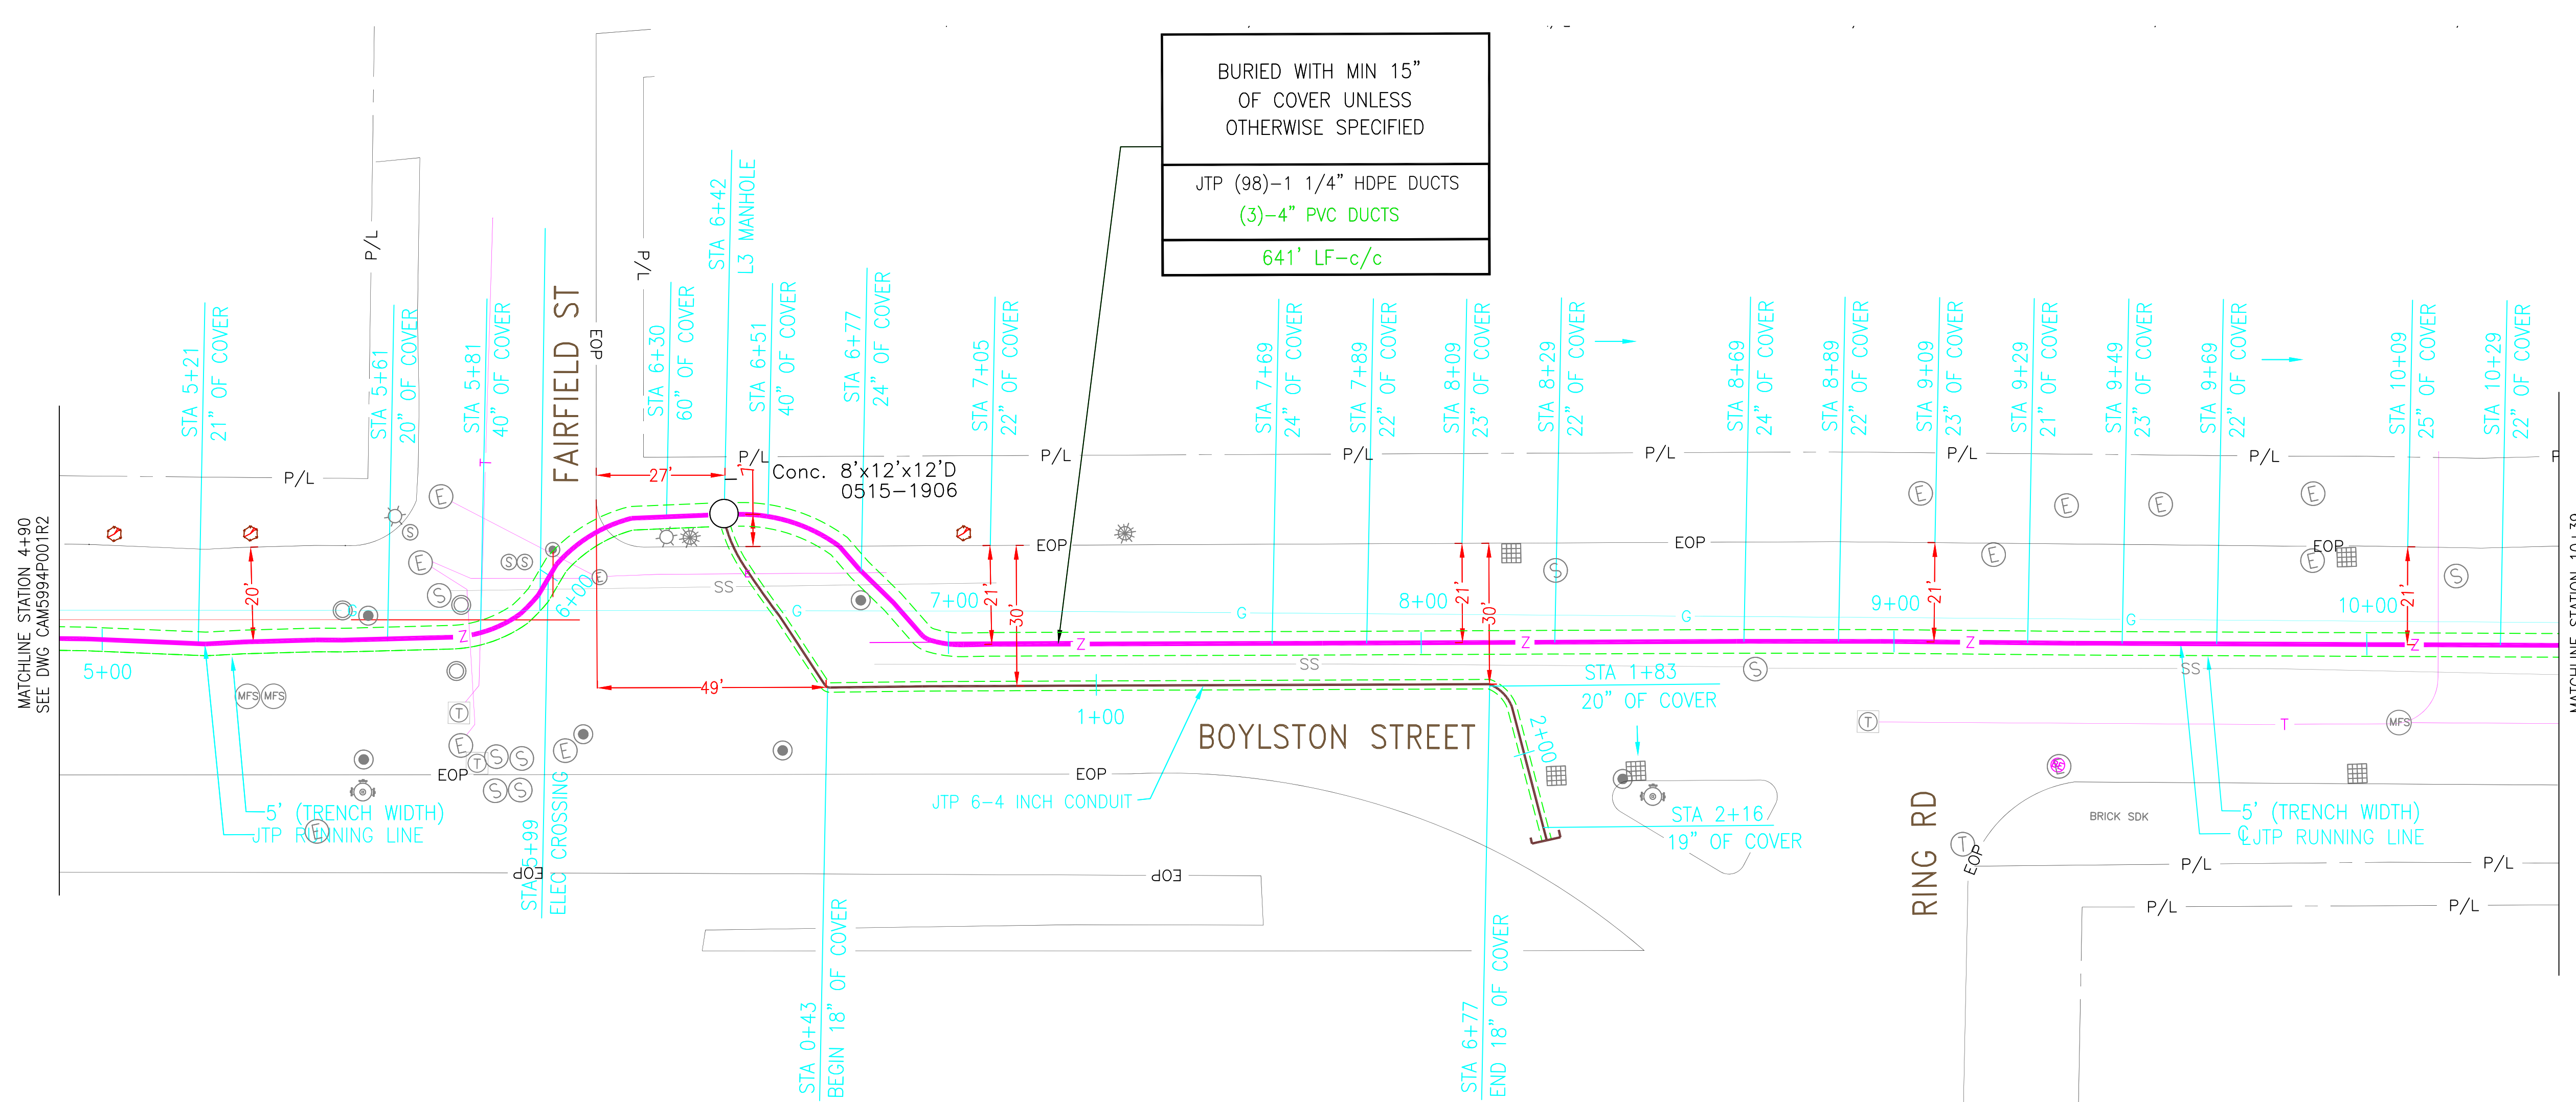

REV	DATE	DESCRIPTION	DESIGN	CHECK	APPV
1	MAR2001	AS BUILT	RM	JB	TB
2	08/2001	AS BUILT (LATERAL)	RM	JB	TB
3	4/14/03	Changed Level 3 reference to JTP	LM	BW	BW



SULLIVAN & MCLAUGHLIN CO.
74 LAWLEY STREET, BOSTON, MA 02122
PHONE: (617) 474-0500 FAX: (617) 474 0505

CONFIDENTIAL
FOR PROPRIETARY USE ONLY
EXCEPT AS MAY BE OTHERWISE PROVIDED
THIS DRAWING SHALL REMAIN THE PROPERTY OF
Level(3)
COMMUNICATIONS
AND SHALL NOT BE REPRODUCED, COPIED, OR USED FOR
ANY PURPOSE WITHOUT SPECIFIC WRITTEN PERMISSION.

DRAWN BY: R. MEJIA
CHECKED BY: J. DEBARROS
APPROVED BY: H. BERTONI



Level(3)
COMMUNICATIONS

LOOP: BOSTON
SEGMENT: A-9A
SITE ADDRESS: BOSTON, MA
TITLE: BOYLSTON STREET

CONTRACT NO: 5994	SHEET:
DRAWING NO: BOS5994P002R2	06
DATE DRAWN: NOV2000	
SCALE: 1" = 40'	
PLOT DATE: 4/14/03	SHEET: 6 OF: 14