


BURIED WITH MIN 15" OF COVER UNLESS OTHERWISE SPECIFIED

JTP (98)-1 1/4" HDPE DUCTS  
(3)-4" PVC DUCTS

699' LF-c/c

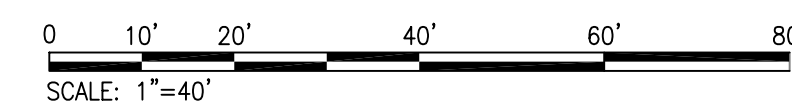

REV	DATE	DESCRIPTION	DESIGNER	CHECKED	APP'D
1	MAR2001	AS BUILT	RM	JB	TJB
1	08/2001	AS BUILT (LATERAL)	RM	JB	TJB
3	4/14/03	Changed Level 3 reference to JTP	LM	EW	EW



**SULLIVAN & MCLAUGHLIN CO.**  
 74 LAWLEY STREET, BOSTON, MA 02122  
 PHONE: (617) 474-0500 FAX: (617) 474 0505

**CONFIDENTIAL**  
 FOR PROPRIETARY USE ONLY  
 EXCEPT AS MAY BE OTHERWISE PROVIDED  
 THIS DRAWING SHALL REMAIN THE PROPERTY OF  
**Level(3)**  
 COMMUNICATIONS  
 AND SHALL NOT BE REPRODUCED, COPIED, OR USED FOR  
 ANY PURPOSE WITHOUT SPECIFIC WRITTEN PERMISSION.

DRAWN BY: R. MEJIA  
 CHECKED BY: J. DEBARROS  
 APPROVED BY: H. BERTONI



**Level(3)**<sup>SM</sup>  
 COMMUNICATIONS

LOOP: BOSTON  
 SEGMENT: A-9A  
 SITE ADDRESS: BOSTON, MA

TITLE: BOYLSTON STREET

CONTRACT NO: 5994  
 DRAWING NO: BOS5994P004R2  
 DATE DRAWN: NOV2000  
 SCALE: 1" = 40'  
 PLOT DATE: 4/14/03

SHEET: 8 OF 14  
 08