

BURIED WITH MIN 15" OF COVER UNLESS OTHERWISE SPECIFIED


JTP (98)-1 1/4" HDPE DUCTS
(3)-4" PVC DUCTS

739' LF-c/c

BURIED WITH MIN 15" OF COVER UNLESS OTHERWISE SPECIFIED

JTP (98)-1 1/4" HDPE DUCTS
(3)-4" PVC DUCTS

967' LF-c/c

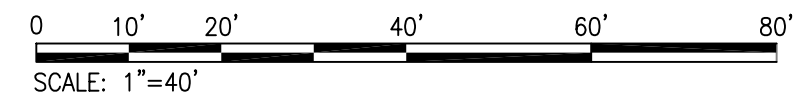

REV	DATE	DESCRIPTION	DESIGNER	CHECKED	APP'D
1	MAR2001	AS BUILT	RM	JB	TB
1	08/2001	AS BUILT (LATERAL)	RM	JB	TB
3	4/14/03	Changed Level 3 reference to JTP	LM	BW	BW



SULLIVAN & MCLAUGHLIN CO.

74 LAWLEY STREET, BOSTON, MA 02122
PHONE: (617) 474-0500 FAX: (617) 474 0505

CONFIDENTIAL
FOR PROPRIETARY USE ONLY
EXCEPT AS MAY BE OTHERWISE PROVIDED
THIS DRAWING SHALL REMAIN THE PROPERTY OF
Level(3)
COMMUNICATIONS
AND SHALL NOT BE REPRODUCED, COPIED, OR USED FOR
ANY PURPOSE WITHOUT SPECIFIC WRITTEN PERMISSION.

DRAWN BY: R. MEJIA

CHECKED BY: J. DEBARROS

APPROVED BY: H. BERTONI



Level(3)
COMMUNICATIONS

LOOP: BOSTON

SEGMENT: A-9A

SITE ADDRESS: BOSTON, MA

TITLE: BOYLSTON STREET

CONTRACT NO: 5994

DRAWING NO: BOS5994P007R2

DATE DRAWN: NOV2000

SCALE: 1" = 40'

PLOT DATE: 4/14/03

SHEET:

SHEET: 11 OF: 14

11