


BURIED WITH MIN 15"
OF COVER UNLESS
OTHERWISE SPECIFIED

JTP (98)-1 1/4" HDPE DUCTS
(3)-4" PVC DUCTS

967' LF-c/c

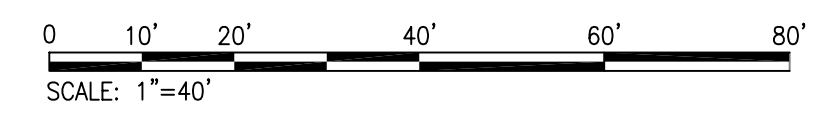

REV	DATE	DESCRIPTION	DESIGN	CHECK	APPV
1	MAR2001	AS BUILT	RM	JB	TJB
1	08/2001	AS BUILT (LATERAL)	RM	JB	TJB
3	4/14/03	Changed Level 3 reference to JTP	LM	EW	EW



SULLIVAN & MCLAUGHLIN CO.
74 LAWLEY STREET, BOSTON, MA 02122
PHONE: (617) 474-0500 FAX: (617) 474 0505

CONFIDENTIAL
FOR PROPRIETARY USE ONLY
EXCEPT AS MAY BE OTHERWISE PROVIDED
THIS DRAWING SHALL REMAIN THE PROPERTY OF
Level(3)
COMMUNICATIONS
AND SHALL NOT BE REPRODUCED, COPIED, OR USED FOR
ANY PURPOSE WITHOUT SPECIFIC WRITTEN PERMISSION.

DRAWN BY: R. MEJIA
CHECKED BY: J. DEBARROS
APPROVED BY: H. BERTONI



Level(3)
COMMUNICATIONS

LOOP: BOSTON
SEGMENT: A-9A
SITE ADDRESS: BOSTON, MA
TITLE: BOYLSTON STREET

CONTRACT NO: 5994 SHEET:
DRAWING NO: BOS5994P008R2
DATE DRAWN: NOV2000
SCALE: N.T.S.
PLOT DATE: 4/14/03 SHEET: 12 OF: 14