


MATCHLINE STATION 46+53  
SEE DWG CAM5994P009R2

BURIED WITH MIN 15" OF COVER UNLESS OTHERWISE SPECIFIED
JTP (98)-1 1/4" HDPE DUCTS (3)-4" PVC DUCTS
615' LF-c/c

FOR CONTINUATION SEE SEGMENT A-8B

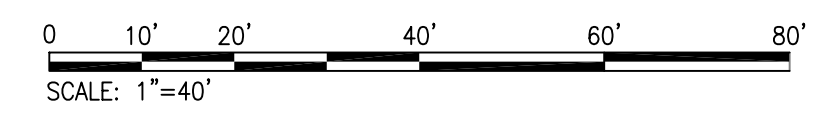

REV	DATE	DESCRIPTION	DESIGNER	CHECKED	APPD
1	MAR2001	AS BUILT	LM	BW	BW
2	4/14/03	Changed Level 3 reference to JTP	LM	BW	BW



**SULLIVAN & MCLAUGHLIN CO.**  
74 LAWLEY STREET, BOSTON, MA 02122  
PHONE: (617) 474-0500 FAX: (617) 474 0505

**CONFIDENTIAL**  
FOR PROPRIETARY USE ONLY  
EXCEPT AS MAY BE OTHERWISE PROVIDED  
THIS DRAWING SHALL REMAIN THE PROPERTY OF  
**Level(3)**  
COMMUNICATIONS  
AND SHALL NOT BE REPRODUCED, COPIED, OR USED FOR  
ANY PURPOSE WITHOUT SPECIFIC WRITTEN PERMISSION.

DRAWN BY: R. MEJIA  
CHECKED BY: J. DEBARROS  
APPROVED BY: H. BERTONI



**Level(3)**  
COMMUNICATIONS

LOOP: BOSTON  
SEGMENT: A-9A  
SITE ADDRESS: BOSTON, MA  
TITLE: BOYLSTON STREET

CONTRACT NO: 5994  
DRAWING NO: BOS5994P010R2  
DATE DRAWN: NOV2000  
SCALE: 1" = 40'  
PLOT DATE: 4/14/03

SHEET:  
**14**  
SHEET:14 OF: 14