


FOR CONTINUATION
SEE SEGMENT A-10




REV	DATE	DESCRIPTION	DESIGNED	CHECKED	BY
1	4/14/03	Changed Level 3 reference to JTP	LM	BW	BW

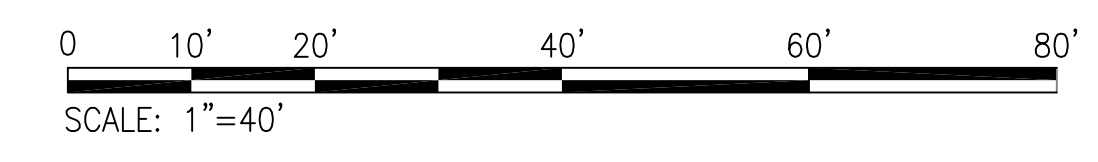

SULLIVAN & McLAUGHLIN CO.
74 LAWLEY STREET, BOSTON, MA 02122
PHONE: (617) 474-0500 FAX: (617) 474 0505

CONFIDENTIAL
FOR PROPRIETARY USE ONLY
EXCEPT AS MAY BE OTHERWISE PROVIDED
THIS DRAWING SHALL REMAIN THE PROPERTY OF
Level (3)
COMMUNICATIONS
AND SHALL NOT BE REPRODUCED, COPIED, OR USED FOR
ANY PURPOSE WITHOUT SPECIFIC WRITTEN PERMISSION.

DRAWN BY: MLS
CHECKED BY: ES
APPROVED BY: MS

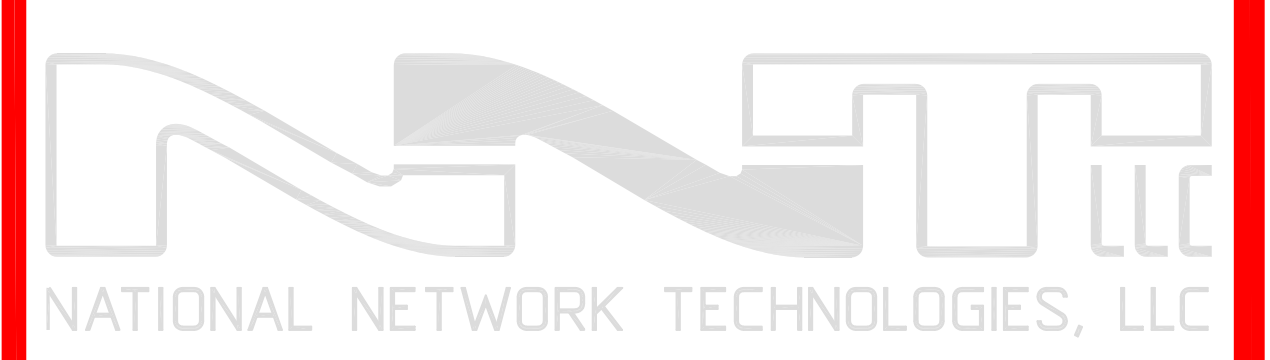

Level (3)SM
COMMUNICATIONS

LOOP: BOSTON
SEGMENT: A-9D
SITE ADDRESS: BOSTON, MA

TITLE:
MASSACHUSETTS AVE & BELVIDERE ST

CONTRACT NO: 5997
DRAWING NO: BOS5997P001R1
DATE DRAWN: 12/26/01
SCALE: 1" = 40'
PLOT DATE: 4/14/03

SHEET:
05
SHEET: 05 OF: 07