

REV	DATE	DESCRIPTION	DESIGNED	CHECKED	BY
1	4/22/03	Changed Level 3 reference to JTP	LM	EW	BW



SULLIVAN & McLAUGHLIN CO.
 74 LAWLEY STREET, BOSTON, MA 02122
 PHONE: (617) 474-0500 FAX: (617) 474 0505

CONFIDENTIAL
 FOR PROPRIETARY USE ONLY
 EXCEPT AS MAY BE OTHERWISE PROVIDED
 THIS DRAWING SHALL REMAIN THE PROPERTY OF
Level (3)
 COMMUNICATIONS
 AND SHALL NOT BE REPRODUCED, COPIED, OR USED FOR
 ANY PURPOSE WITHOUT SPECIFIC WRITTEN PERMISSION.

DRAWN BY: MLS
 CHECKED BY: ES
 APPROVED BY: MS




Level (3)SM
 COMMUNICATIONS

LOOP: BOSTON
 SEGMENT: A-9D
 SITE ADDRESS: BOSTON, MA

TITLE: BELVIDERE ST

CONTRACT NO: 5997	SHEET: 06 OF: 07
DRAWING NO: BOS5997P002R1	
DATE DRAWN: 12/26/01	
SCALE: 1" = 40'	
PLOT DATE: 4/22/03	

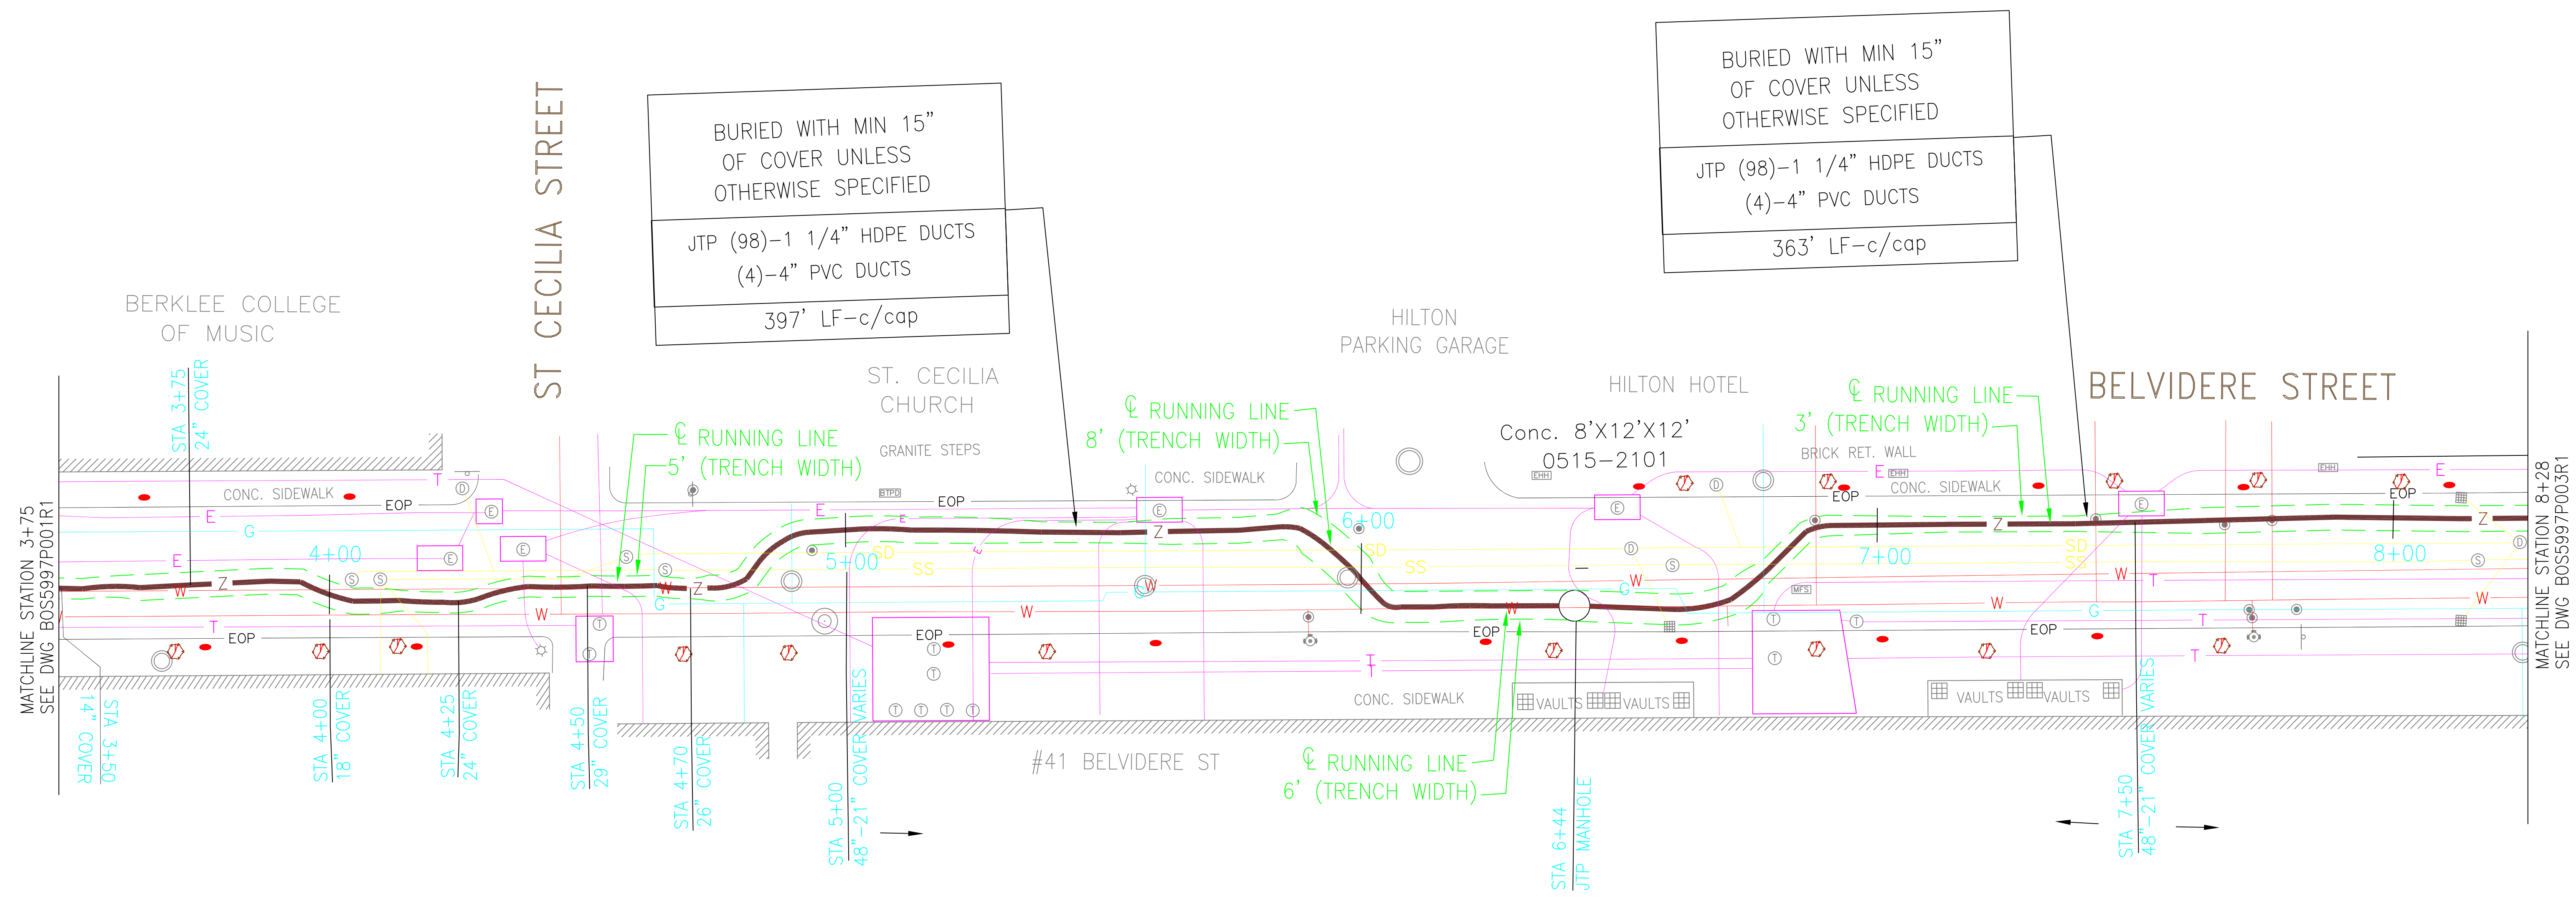

BURIED WITH MIN 15"
 OF COVER UNLESS
 OTHERWISE SPECIFIED
 JTP (98)-1 1/4" HDPE DUCTS
 (4)-4" PVC DUCTS
 397' LF-c/cap

BURIED WITH MIN 15"
 OF COVER UNLESS
 OTHERWISE SPECIFIED
 JTP (98)-1 1/4" HDPE DUCTS
 (4)-4" PVC DUCTS
 363' LF-c/cap

