




BURIED WITH MIN 30"  
OF COVER UNLESS  
OTHERWISE SPECIFIED

JTP (94)-1 1/4" HPDE DUCTS  
(1)-4" PVC DUCT

509' LF-c/c

SEE DWG CAM5981P003R1  
MATCHLINE STATION 1+53

FOR CONTINUATION SEE SEGMENT A-13

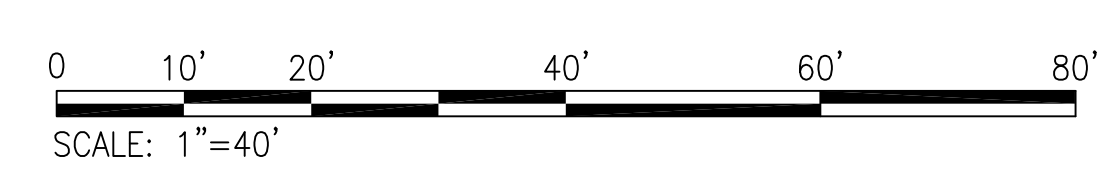

REV	DATE	DESCRIPTION	DESIGNER	CHECKED	APPROVED
1	MAR2001	AS BUILT	RM	JB	HB
2	4/14/03	Changed Level 3 reference to JTP	LM	BW	BW



**SULLIVAN & MCLAUGHLIN CO.**  
74 LAWLEY STREET, BOSTON, MA 02122  
PHONE: (617) 474-0500 FAX: (617) 474 0505

**CONFIDENTIAL**  
FOR PROPRIETARY USE ONLY  
EXCEPT AS MAY BE OTHERWISE PROVIDED  
THIS DRAWING SHALL REMAIN THE PROPERTY OF  
**Level (3)**  
COMMUNICATIONS  
AND SHALL NOT BE REPRODUCED, COPIED, OR USED FOR  
ANY PURPOSE WITHOUT SPECIFIC WRITTEN PERMISSION.

DRAWN BY: R. MEJIA  
CHECKED BY: J. DE BARROS  
APPROVED BY: H. BERTONI



**Level (3)**<sup>SM</sup>  
COMMUNICATIONS

LOOP: CAMBRIDGE  
SEGMENT: A-14  
SITE ADDRESS: CAMBRIDGE, MA

TITLE: MASS AVE AND MEMORIAL DR

CONTRACT NO: 5981  
DRAWING NO: CAM5981P004R1  
DATE DRAWN: MAY2000  
SCALE: 1" = 40'  
PLOT DATE: 4/14/03

SHEET: 8 OF: 8

08