

REV	DATE	DESCRIPTION	DESIGNED	CHECKED	BY
1	3/27/03	Changed Level 3 reference to JTP	LM	EW	BW



SULLIVAN & MCLAUGHLIN CO.
 74 LAWLEY STREET, BOSTON, MA 02122
 PHONE: (617) 474-0500 FAX: (617) 474 0505

CONFIDENTIAL
 FOR PROPRIETARY USE ONLY
 EXCEPT AS MAY BE OTHERWISE PROVIDED
 THIS DRAWING SHALL REMAIN THE PROPERTY OF
Level (3)
 COMMUNICATIONS
 AND SHALL NOT BE REPRODUCED, COPIED, OR USED FOR
 ANY PURPOSE WITHOUT SPECIFIC WRITTEN PERMISSION.

DRAWN BY: LS
 CHECKED BY: ES
 APPROVED BY: MS




Level (3)SM
 COMMUNICATIONS

LOOP: CAMBRIDGE
 SEGMENT: A-15
 SITE ADDRESS: CAMBRIDGE, MA

TITLE: ALBANY ST

CONTRACT NO: 5982	SHEET: 05 OF: 11
DRAWING NO: CAM5982P001R1	
DATE DRAWN: 08/03/00	
SCALE: 1" = 40'	
PLOT DATE: 4/15/03	

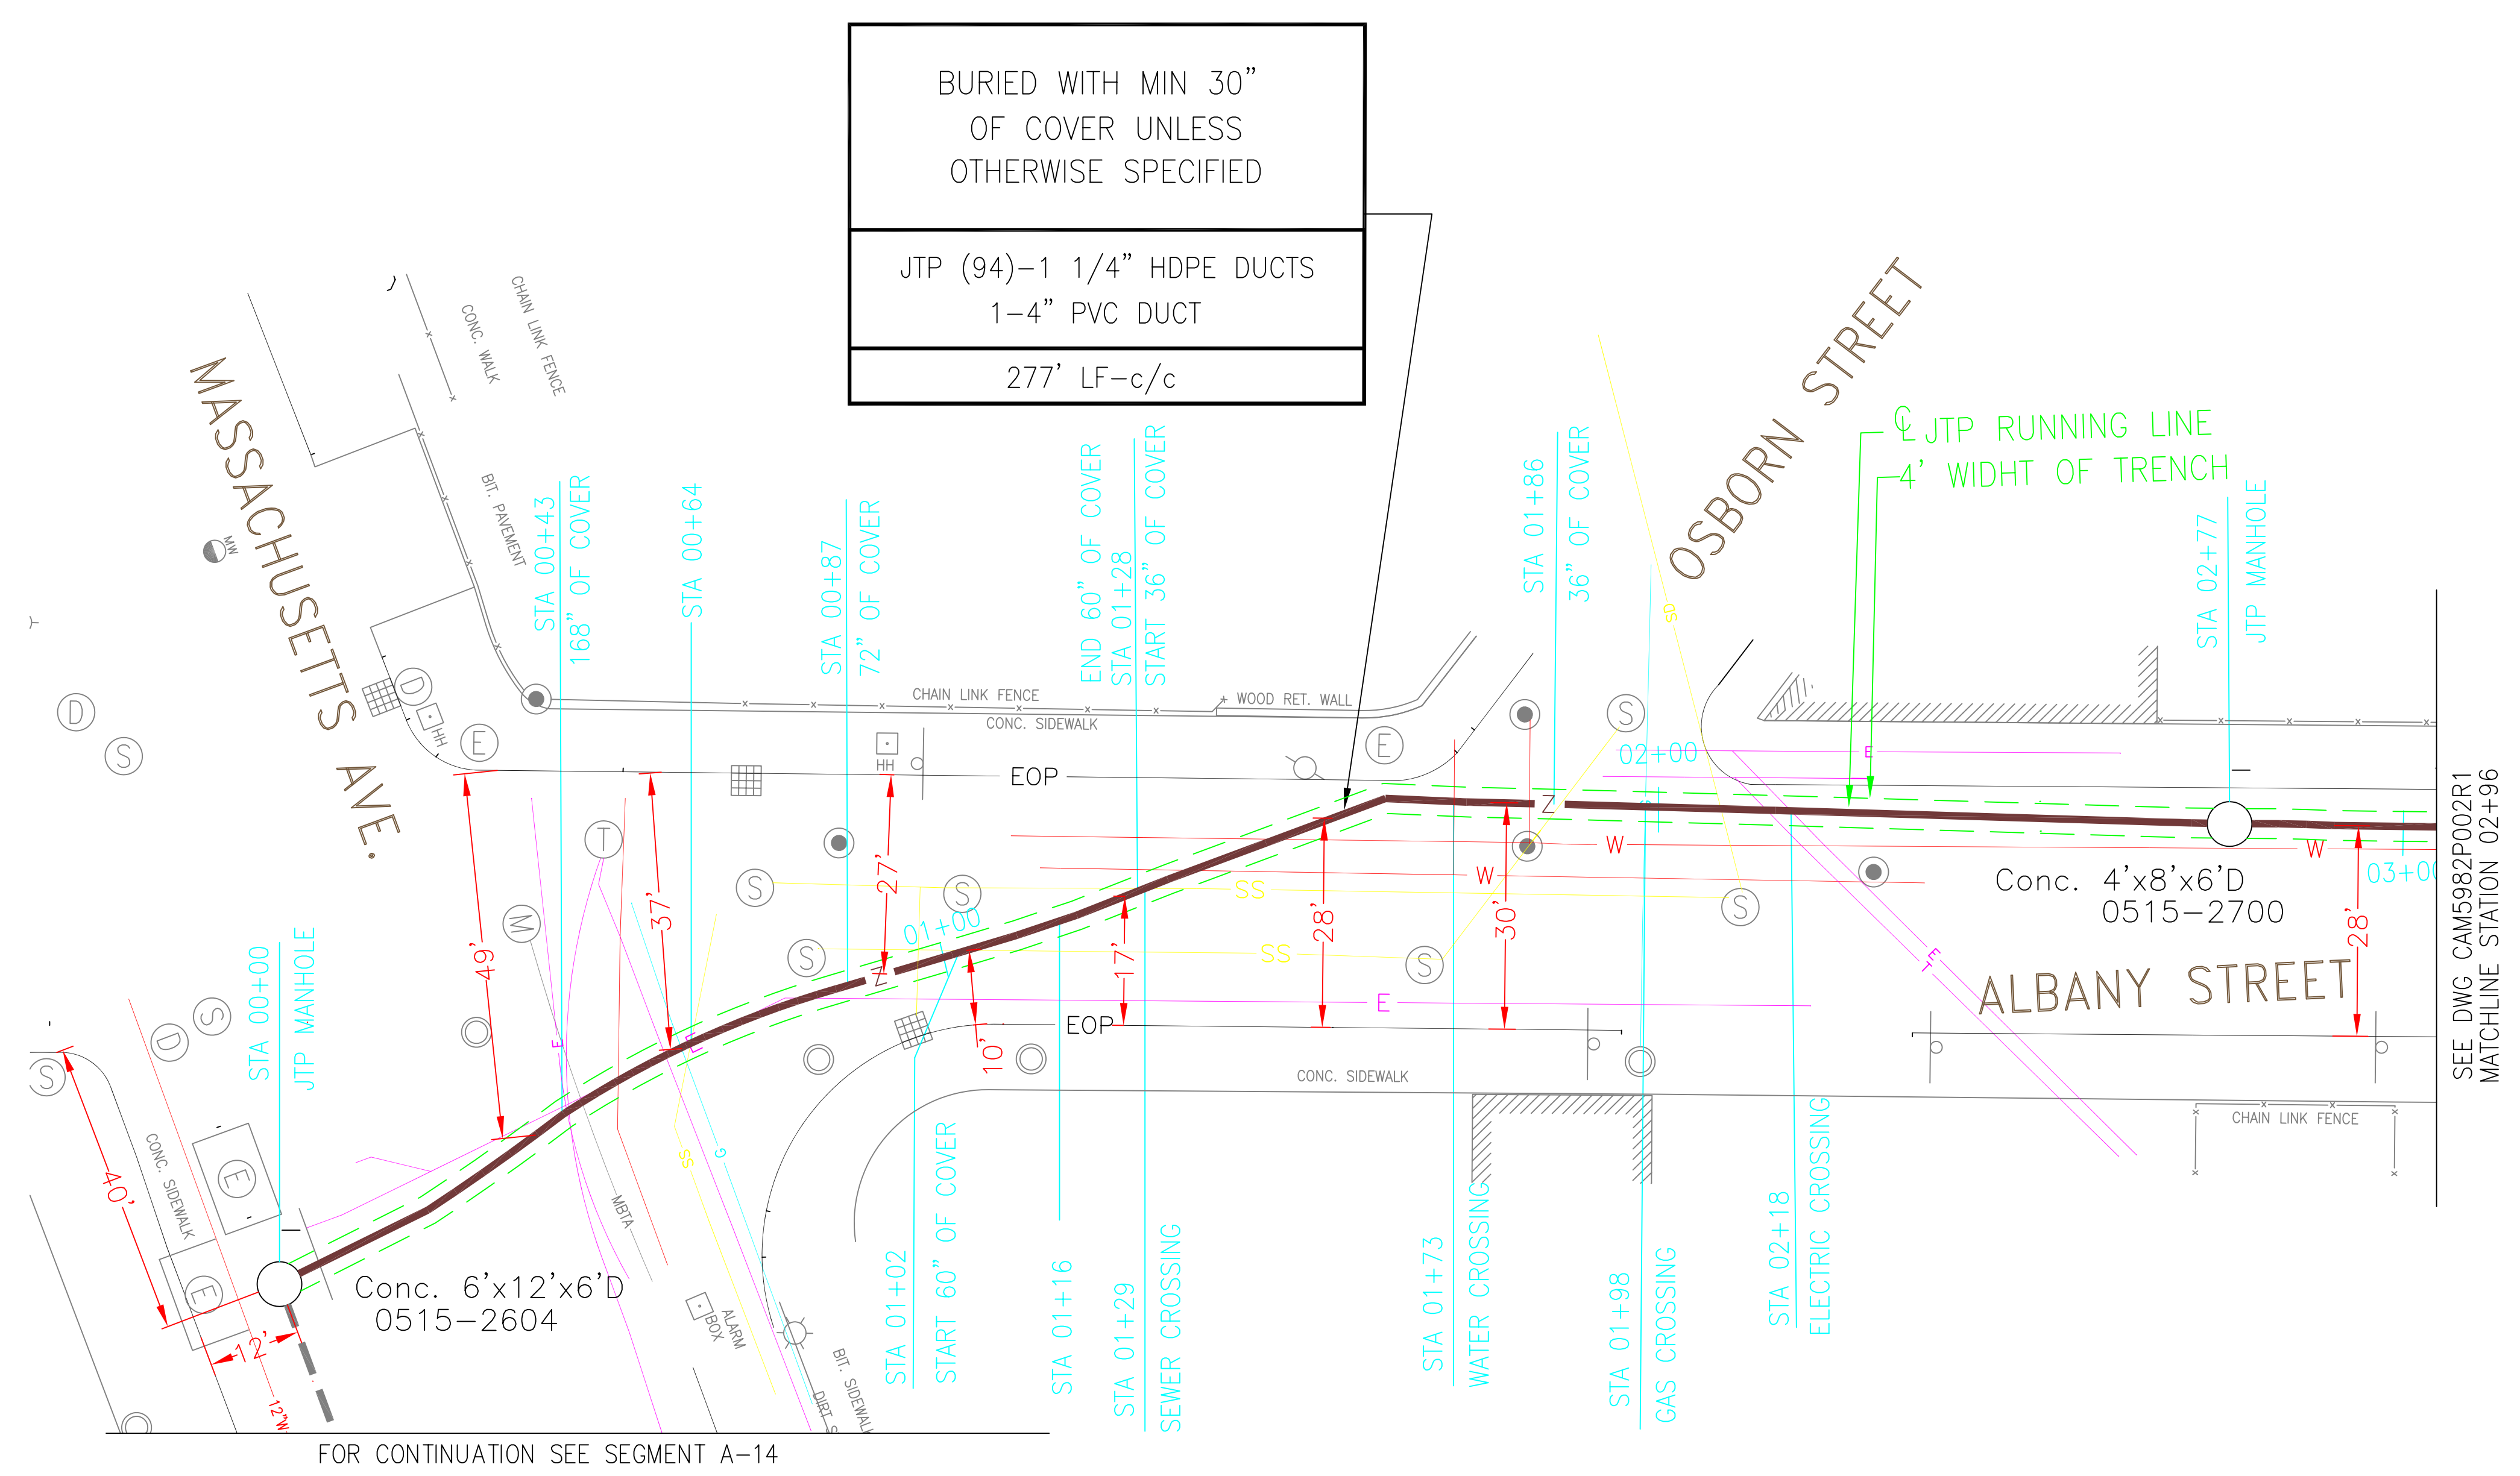

BURIED WITH MIN 30"
 OF COVER UNLESS
 OTHERWISE SPECIFIED

JTP (94)-1 1/4" HDPE DUCTS
 1-4" PVC DUCT
 277' LF-c/c

