

BURIED WITH MIN 30"  
OF COVER UNLESS  
OTHERWISE SPECIFIED


JTP (94)-1 1/4" HDPE DUCTS  
1-4" PVC DUCT

524' LF-c/c

☐ JTP RUNNING LINE  
4' WIDTH OF TRENCH

SEE DWG CAM5982P002R1  
MATCHLINE STATION 06+54

SEE DWG CAM5982P004R1  
MATCHLINE STATION 10+51

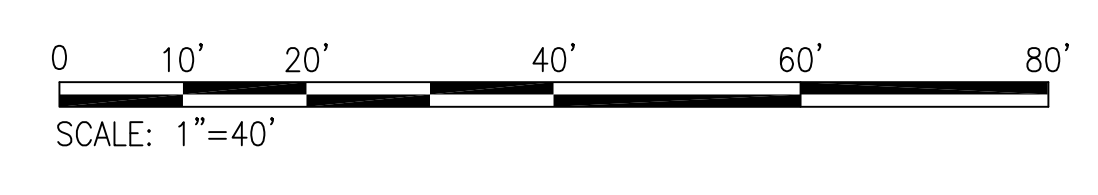

REV	DATE	DESCRIPTION	DESIGNED	CHECKED	BY
1	4/15/03	Changed Level 3 reference to JTP	LM	BW	BW



**SULLIVAN & MCLAUGHLIN CO.**  
74 LAWLEY STREET, BOSTON, MA 02122  
PHONE: (617) 474-0500 FAX: (617) 474 0505

**CONFIDENTIAL**  
FOR PROPRIETARY USE ONLY  
EXCEPT AS MAY BE OTHERWISE PROVIDED  
THIS DRAWING SHALL REMAIN THE PROPERTY OF  
**Level (3)**  
COMMUNICATIONS  
AND SHALL NOT BE REPRODUCED, COPIED, OR USED FOR  
ANY PURPOSE WITHOUT SPECIFIC WRITTEN PERMISSION.

DRAWN BY: LS  
CHECKED BY: ES  
APPROVED BY: MS



**Level (3)**<sup>SM</sup>  
COMMUNICATIONS

LOOP: CAMBRIDGE  
SEGMENT: A-15  
SITE ADDRESS: CAMBRIDGE, MA

TITLE: ALBANY ST

CONTRACT NO: 5982  
DRAWING NO: CAM5982P003R1  
DATE DRAWN: 08/03/00  
SCALE: 1" = 40'  
PLOT DATE: 4/15/03

SHEET: 07 OF 11