

SEE DWG. CAM5982P006R1
MATCHLINE STATION 19+87

SEE DWG. CAM5982P007R1
MATCHLINE STATION 24+14


REV	DATE	DESCRIPTION	DESIGNED	CHECKED	BY
1	4/15/03	Changed Level 3 reference to JTP	LM	BW	BW



SULLIVAN & MCLAUGHLIN CO.
74 LAWLEY STREET, BOSTON, MA 02122
PHONE: (617) 474-0500 FAX: (617) 474 0505

CONFIDENTIAL
FOR PROPRIETARY USE ONLY
EXCEPT AS MAY BE OTHERWISE PROVIDED
THIS DRAWING SHALL REMAIN THE PROPERTY OF
Level (3)
COMMUNICATIONS
AND SHALL NOT BE REPRODUCED, COPIED, OR USED FOR
ANY PURPOSE WITHOUT SPECIFIC WRITTEN PERMISSION.

DRAWN BY: LS
CHECKED BY: ES
APPROVED BY: MS

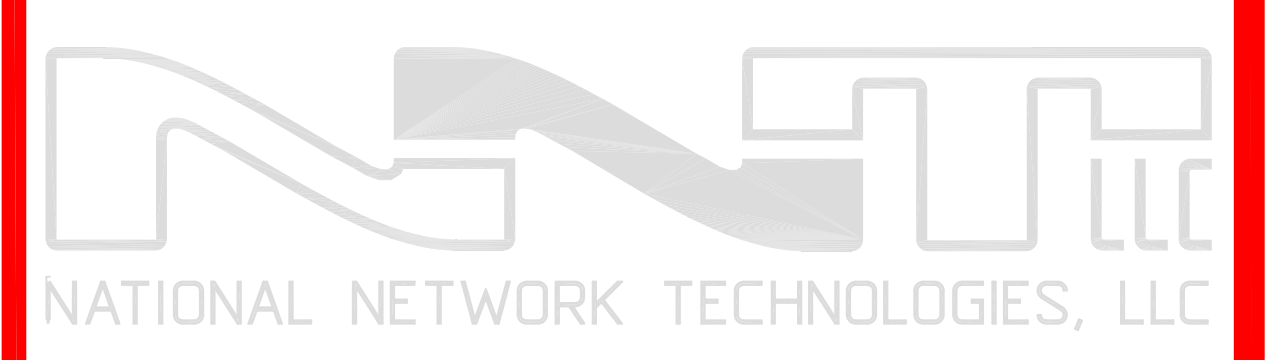

Level (3)SM
COMMUNICATIONS

LOOP: CAMBRIDGE
SEGMENT: A-15
SITE ADDRESS: CAMBRIDGE, MA

TITLE: GALILEO GALILEI WAY

CONTRACT NO: 5982
DRAWING NO: CAM5982P006R1
DATE DRAWN: 08/03/00
SCALE: 1" = 40'
PLOT DATE: 4/15/03

SHEET: 10 OF 11

