

REV	DATE	DESCRIPTION	DESIGNER	CHECKED	APP'D
1	2/8/2000	BUILT	RM	ES	MS
2	4/09/03	Changed Level 3 reference to JTP	LM	BW	BW




SULLIVAN & MCLAUGHLIN CO.

74 LAWLEY STREET, BOSTON, MA 02122
 PHONE: (617) 474-0500 FAX: (617) 474 0505

CONFIDENTIAL
 FOR PROPRIETARY USE ONLY
 EXCEPT AS MAY BE OTHERWISE PROVIDED
 THIS DRAWING SHALL REMAIN THE PROPERTY OF
Level(3)
 COMMUNICATIONS
 AND SHALL NOT BE REPRODUCED, COPIED, OR USED FOR
 ANY PURPOSE WITHOUT SPECIFIC WRITTEN PERMISSION.

DRAWN BY: R. MEJIA
 CHECKED BY: E. SPITZER
 APPROVED BY: M. SARACEND

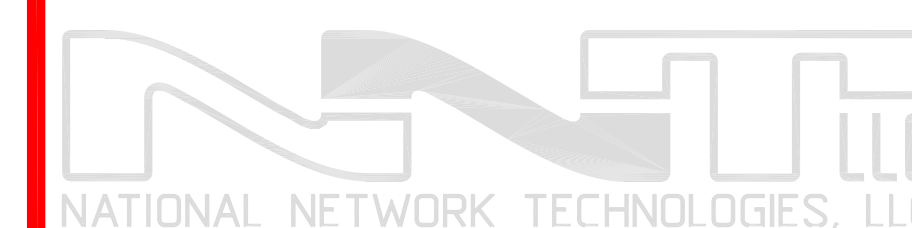

Level(3)
 COMMUNICATIONS

LOOP: CAMBRIDGE
 SEGMENT: A-2
 SITE ADDRESS: THIRD ST
 CAMBRIDGE, MA
 TITLE: AS-BUILT
 PLANS

CONTRACT NO: 5986
 DRAWING NO: CAM5986P001R1
 DATE DRAWN: 7/2/2000
 SCALE: 1" = 40'
 PLOT DATE: APR 09, 2003

SHEET:
05
 SHEET: 5 OF: 6

