


BURIED WITH MIN 30"
OF COVER UNLESS
OTHERWISE SPECIFIED

JTP (86)-1" 1/4 HPDE DUCTS

587' LF c/c

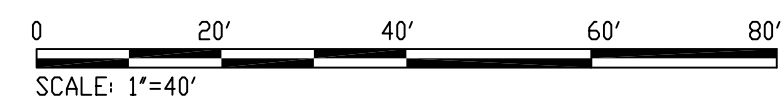

REV	DATE	DESCRIPTION	DESIGNER	CHECKED	APP'D
1	2/8/2003				
2	4/09/03	Changed Level 3 reference to JTP	LM	BW	BW



SULLIVAN & MCLAUGHLIN CO.
74 LAWLEY STREET, BOSTON, MA 02122
PHONE: (617) 474-0500 FAX: (617) 474 0505

CONFIDENTIAL
FOR PROPRIETARY USE ONLY
THIS DRAWING SHALL REMAIN THE PROPERTY OF
Level(3)
COMMUNICATIONS
AND SHALL NOT BE REPRODUCED, COPIED, OR USED FOR
ANY PURPOSE WITHOUT SPECIFIC WRITTEN PERMISSION.

DRAWN BY: R. MEJIA
CHECKED BY: E. SPITZER
APPROVED BY: M. SARACEND



Level(3)
COMMUNICATIONS

LOOP: CAMBRIDGE
SEGMENT: A-2
SITE ADDRESS: THIRD ST
CAMBRIDGE, MA
TITLE: AS-BUILT
PLANS

CONTRACT NO: 5986
DRAWING NO: CAM5986P002R1
DATE DRAWN: 7/3/2000
SCALE: 1" = 40'
PLOT DATE: APR 09, 2003

SHEET:
06
SHEET: 6 OF: 6