

REV	DATE	DESCRIPTION	DESIGNER	CHECKED	APP'D
1	DEC2001	AS BUILT	RM		
2	4/10/03	Changed Level 3 reference to JTP	LM	BW	BW



**SULLIVAN & MCLAUGHLIN CO.**


74 LAWLEY STREET, BOSTON, MA 02122  
 PHONE: (617) 474-0500 FAX: (617) 474 0505

**CONFIDENTIAL**  
 FOR PROPRIETARY USE ONLY  
 EXCEPT AS MAY BE OTHERWISE PROVIDED  
 THIS DRAWING SHALL REMAIN THE PROPERTY OF  
**Level(3)**  
 COMMUNICATIONS  
 AND SHALL NOT BE REPRODUCED, COPIED, OR USED FOR  
 ANY PURPOSE WITHOUT SPECIFIC WRITTEN PERMISSION.

DRAWN BY: R.M.

CHECKED BY: M.S.

APPROVED BY: E.S.

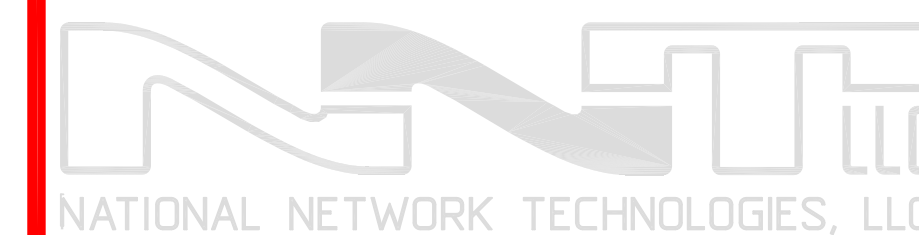

**Level(3)**<sup>SM</sup>  
 COMMUNICATIONS

LOOP: A LOOP

SEGMENT: A-3

SITE ADDRESS: THIRD STREET  
 BOSTON, MA

TITLE: AS-BUILT PLANS

CONTRACT NO: 5987

DRAWING NO: CAM5987P001R1

DATE DRAWN: DEC2001

SCALE: 1" = 40'-0"

PLOT DATE: APR 09, 2003

SHEET:

05

SHEET5 OF: 7

