


- STA 0+00
- JTP MANHOLE
- STA 0+10
- 38" OF COVER
- STA 0+30
- 38" OF COVER
- STA 0+35
- 38" OF COVER
- STA 0+38
- 25" OF COVER
- STA 0+48
- 12" OF COVER
- STA 0+58
- 10" OF COVER
- STA 0+68
- 10" OF COVER
- STA 0+78
- 11" OF COVER
- STA 0+88
- 21" OF COVER
- STA 1+00
- 25" OF COVER
- STA 1+23
- 12" OF COVER

BURIED WITH MIN 30"
OF COVER UNLESS
OTHERWISE SPECIFIED

JTP (96)-1 1/4" HDPE DUCTS

540' LF-c/c

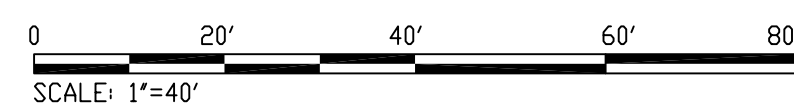

REV	DATE	DESCRIPTION	DESIGNER	CHECKED	APPROV
2	4/10/03	Changed Level 3 reference to JTP	LM	BW	BW



SULLIVAN & MCLAUGHLIN CO.
74 LAWLEY STREET, BOSTON, MA 02122
PHONE: (617) 474-0500 FAX: (617) 474 0505

CONFIDENTIAL
FOR PROPRIETARY USE ONLY
EXCEPT AS MAY BE OTHERWISE PROVIDED
THIS DRAWING SHALL REMAIN THE PROPERTY OF
Level(3)
COMMUNICATIONS
AND SHALL NOT BE REPRODUCED, COPIED, OR USED FOR
ANY PURPOSE WITHOUT SPECIFIC WRITTEN PERMISSION.

DRAWN BY: JT
CHECKED BY: ES
APPROVED BY: MS



Level(3)SM
COMMUNICATIONS

LOOP: CAMBRIDGE
SEGMENT: A-4
SITE ADDRESS: THIRD ST
CAMBRIDGE, MA
TITLE: AS-BUILT PLANS

CONTRACT NO: 5988
DRAWING NO: CAM5988P001R1
DATE DRAWN: 11/28/01
SCALE: 1" = 40'
PLDT DATE: 04/09/03

SHEET: 5 OF 7

05