


| REV | DATE | DESCRIPTION | DESIGNER | CHECKED | APPROVED |
|-----|---------|----------------------------------|----------|---------|----------|
| 1 | 7/08/03 | Changed Level 3 reference to JTP | LM | BW | BW |
| | | | | | |
| | | | | | |
| | | | | | |
| | | | | | |



SULLIVAN & MCLAUGHLIN CO.
 74 LAWLEY STREET, BOSTON, MA 02122
 PHONE: (617) 474-0500 FAX: (617) 474 0505

CONFIDENTIAL
 FOR PROPRIETARY USE ONLY
 EXCEPT AS MAY BE OTHERWISE PROVIDED
 THIS DRAWING SHALL REMAIN THE PROPERTY OF
Level(3)
 COMMUNICATIONS
 AND SHALL NOT BE REPRODUCED, COPIED, OR USED FOR
 ANY PURPOSE WITHOUT SPECIFIC WRITTEN PERMISSION.

DRAWN BY: JT
 CHECKED BY: ES
 APPROVED BY: MS

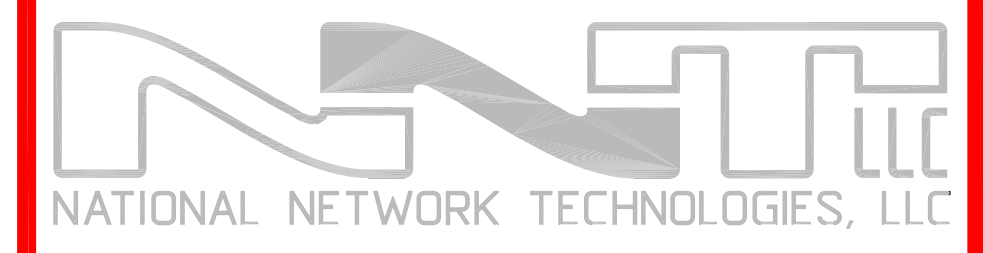

Level(3)SM
 COMMUNICATIONS

LOOP: CAMBRIDGE
 SEGMENT: A-4
 SITE ADDRESS: THIRD ST
 CAMBRIDGE, MA
 TITLE: AS-BUILT PLANS

| | |
|---------------------------|-------------------------|
| CONTRACT NO: 5988 | SHEET: 08 |
| DRAWING NO: CAM5988P004R1 | |
| DATE DRAWN: 11/28/01 | |
| SCALE: 1" = 40' | |
| PLDT DATE: 04/09/03 | |

SHEET: 8 OF: 8

