

(APPROX. TOWN LINE)
 RLINGTON
 AMBRIDGE


COMMONWEALTH OF MASSACHUSETTS
 METROPOLITAN DISTRICT COMMISSION

BURIED WITH MIN 30"
 OF COVER UNLESS
 OTHERWISE SPECIFIED

JTP (60)-1 1/4"
 PVC DUCTS

434' LF-c/c

APPROXIMATE LOCATION
 OF RED LINE TUNNEL
 TAKEN FROM PLANS PREPARED BY
 LAMSON ENGINEERING FOR
 MHD PROJECT #600462

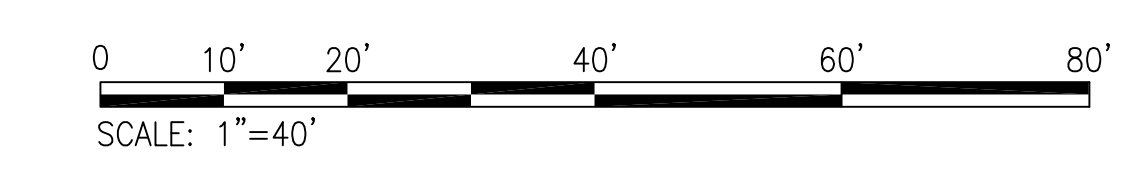

| REV | DATE | DESCRIPTION | DESIGNED | CHECKED | BY |
|-----|---------|----------------------------------|----------|---------|-----|
| 1 | MAR2001 | | LM | JIS | HIS |
| 2 | 4/17/03 | Changed Level 3 reference to JTP | LM | BW | EW |



SULLIVAN & MCLAUGHLIN CO.
 74 LAWLEY STREET, BOSTON, MA 02122
 PHONE: (617) 474-0500 FAX: (617) 474 0505

CONFIDENTIAL
 FOR PROPRIETARY USE ONLY
 EXCEPT AS MAY BE OTHERWISE PROVIDED
 THIS DRAWING SHALL REMAIN THE PROPERTY OF
Level (3)
 COMMUNICATIONS
 AND SHALL NOT BE REPRODUCED, COPIED, OR USED FOR
 ANY PURPOSE WITHOUT SPECIFIC WRITTEN PERMISSION.

DRAWN BY: R. MEJIA
 CHECKED BY: J. DE BARROS
 APPROVED BY: H. BERTONI



Level (3)SM
 COMMUNICATIONS

LOOP: CAMBRIDGE
 SEGMENT: C-5A
 SITE ADDRESS:
 CAMBRIDGE, MA

TITLE:
 CONCORD TURNPIKE

CONTRACT NO: 8722
 DRAWING NO: CAM8722P002R1
 DATE DRAWN: JULY2000
 SCALE: 1" = 40'
 PLOT DATE: 4/17/03

SHEET: 6 OF 12

06