




BURIED WITH MIN 30"
OF COVER UNLESS
OTHERWISE SPECIFIED

JTP (60)-1 1/4"
PVC DUCTS

1103' LF-c/c

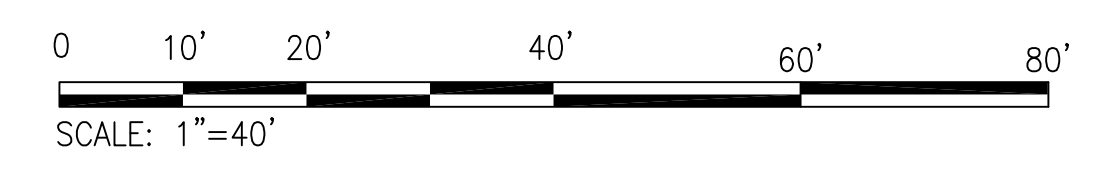

REV	DATE	DESCRIPTION	DESIGNED	CHECKED	BY
1	MAR2001				
2	4/17/03	Changed Level 3 reference to JTP			



SULLIVAN & MCLAUGHLIN CO.
74 LAWLEY STREET, BOSTON, MA 02122
PHONE: (617) 474-0500 FAX: (617) 474 0505

CONFIDENTIAL
FOR PROPRIETARY USE ONLY
EXCEPT AS MAY BE OTHERWISE PROVIDED
THIS DRAWING SHALL REMAIN THE PROPERTY OF
Level(3)
COMMUNICATIONS
AND SHALL NOT BE REPRODUCED, COPIED, OR USED FOR
ANY PURPOSE WITHOUT SPECIFIC WRITTEN PERMISSION.

DRAWN BY: R. MEJIA
CHECKED BY: J. DE BARROS
APPROVED BY: H. BERTONI



Level(3)SM
COMMUNICATIONS

LOOP: CAMBRIDGE
SEGMENT: C-5A
SITE ADDRESS: CAMBRIDGE, MA

TITLE: ALEWIFE BROOK PARKWAY

CONTRACT NO: 8722
DRAWING NO: CAM8722P006R1
DATE DRAWN: JULY2000
SCALE: 1" = 40'
PLOT DATE: 4/17/03

SHEET: 10 OF 12