


FOR CONTINUATION SEE SEGMENT C-5A

MATCHLINE STATION 02+89
SEE DWG CAM8723P002R1



REV	DATE	DESCRIPTION	DESIGNED	CHECKED	BY
1	MAR2001		LS	JB	HG
2	4/17/03	Changed Level 3 reference to JTP	LM	BW	BW

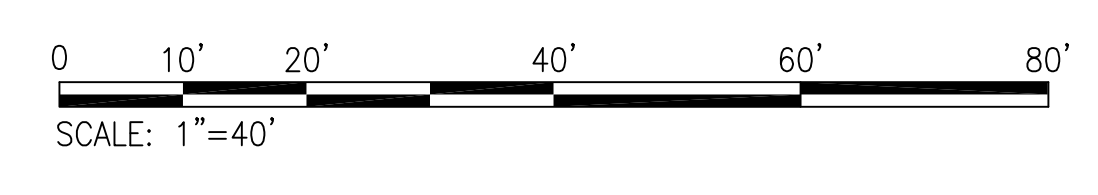

SULLIVAN & MCLAUGHLIN CO.
74 LAWLEY STREET, BOSTON, MA 02122
PHONE: (617) 474-0500 FAX: (617) 474 0505

CONFIDENTIAL
FOR PROPRIETARY USE ONLY
EXCEPT AS MAY BE OTHERWISE PROVIDED
THIS DRAWING SHALL REMAIN THE PROPERTY OF
Level (3)
COMMUNICATIONS
AND SHALL NOT BE REPRODUCED, COPIED, OR USED FOR
ANY PURPOSE WITHOUT SPECIFIC WRITTEN PERMISSION.

DRAWN BY: L. SCOTTO
CHECKED BY: J. DEBARROS
APPROVED BY: H. BERTONI



Level (3)SM
COMMUNICATIONS

LOOP: CAMBRIDGE & SOMERVILLE
SEGMENT: C-5F
SITE ADDRESS: CAMBRIDGE, MA

TITLE: ALEWIFE BROOK PARKWAY

CONTRACT NO: 8723
DRAWING NO: CAM8723P001R1
DATE DRAWN: SEPT2000
SCALE: 1" = 40'
PLOT DATE: 4/17/03

SHEET: 5 OF 9
05