

BURIED WITH MIN 30"
OF COVER UNLESS
OTHERWISE SPECIFIED

JTP 60- 1 1/4" HDPE DUCTS

617' LF-c\c

REV	DATE	DESCRIPTION	DESIGNED	CHECKED	BY
1	MAR2001	AS BUILT	LS	JB	HID
2	4/17/03	Changed Level 3 reference to JTP	LM	BW	EW



SULLIVAN & MCLAUGHLIN CO.
74 LAWLEY STREET, BOSTON, MA 02122
PHONE: (617) 474-0500 FAX: (617) 474 0505

CONFIDENTIAL
FOR PROPRIETARY USE ONLY
EXCEPT AS MAY BE OTHERWISE PROVIDED
THIS DRAWING SHALL REMAIN THE PROPERTY OF
Level (3)
COMMUNICATIONS
AND SHALL NOT BE REPRODUCED, COPIED, OR USED FOR
ANY PURPOSE WITHOUT SPECIFIC WRITTEN PERMISSION.

DRAWN BY: L. SCOTTO

CHECKED BY: J. DEBARROS

APPROVED BY: H. BERTONI



Level (3)SM
COMMUNICATIONS

LOOP: CAMBRIDGE & SOMERVILLE

SEGMENT: C-5F

SITE ADDRESS:
SOMERVILLE, MA

TITLE:
ALEWIFE BROOK PARKWAY

CONTRACT NO: 8723

DRAWING NO: SOM8723P005R1

DATE DRAWN: SEPT2000


SCALE: 1" = 40'

PLOT DATE: 4/17/03

SHEET:

09

SHEET: 9 OF: 9

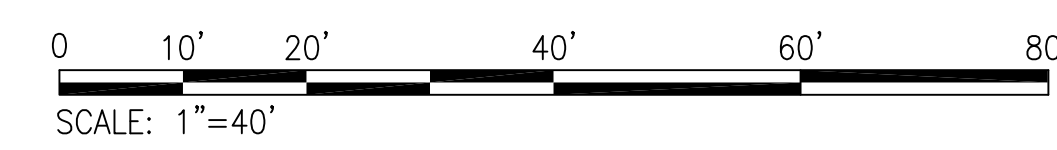

FOR CONTINUATION SEE SEGMENT C-5G