


BURIED WITH MIN 30" OF COVER UNLESS OTHERWISE SPECIFIED

JTP (64)-1 1/4" PATHWAYS
7-4" CONDUIT

594' LF-c/c

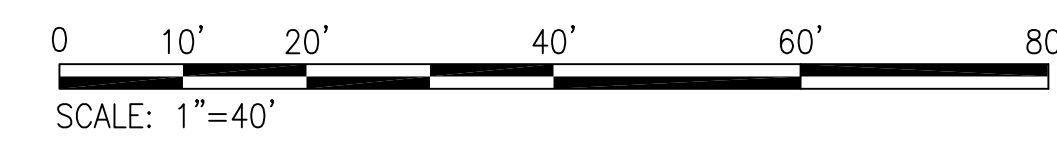

REV	DATE	DESCRIPTION	DESIGNED	CHECKED	BY
1	MAR2001	AS BUILT	TM	JB	HS
2	4/18/03	Changed Level 3 reference to JTP	LM	EW	EW



SULLIVAN & MCLAUGHLIN CO.
74 LAWLEY STREET, BOSTON, MA 02122
PHONE: (617) 474-0500 FAX: (617) 474 0505

CONFIDENTIAL
FOR PROPRIETARY USE ONLY
EXCEPT AS MAY BE OTHERWISE PROVIDED
THIS DRAWING SHALL REMAIN THE PROPERTY OF
Level (3)
COMMUNICATIONS
AND SHALL NOT BE REPRODUCED, COPIED, OR USED FOR ANY PURPOSE WITHOUT SPECIFIC WRITTEN PERMISSION.

DRAWN BY: R. MEJIA
CHECKED BY: J. DE BARROS
APPROVED BY: H. BERTONI



Level (3)SM
COMMUNICATIONS

LOOP: SOMERVILLE
SEGMENT: C-5G
SITE ADDRESS: SOMERVILLE, MA

TITLE: ELM ST

CONTRACT NO: 8724	SHEET: 14 OF 24
DRAWING NO: SOM8724P010R1	
DATE DRAWN: SEPT 2000	
SCALE: 1" = 40'	
PLOT DATE: 4/18/03	