


REV	DATE	DESCRIPTION	DESIGNED	CHECKED	BY
1	MAR2001	AS BUILT	TM	JB	HE
2	4/18/03	Changed Level 3 reference to JTP	LM	EW	BY



SULLIVAN & MCLAUGHLIN CO.
 74 LAWLEY STREET, BOSTON, MA 02122
 PHONE: (617) 474-0500 FAX: (617) 474 0505

CONFIDENTIAL
 FOR PROPRIETARY USE ONLY
 EXCEPT AS MAY BE OTHERWISE PROVIDED
 THIS DRAWING SHALL REMAIN THE PROPERTY OF
Level (3)
 COMMUNICATIONS
 AND SHALL NOT BE REPRODUCED, COPIED, OR USED FOR
 ANY PURPOSE WITHOUT SPECIFIC WRITTEN PERMISSION.

DRAWN BY: R. MEJIA
 CHECKED BY: J. DE BARROS
 APPROVED BY: H. BERTONI

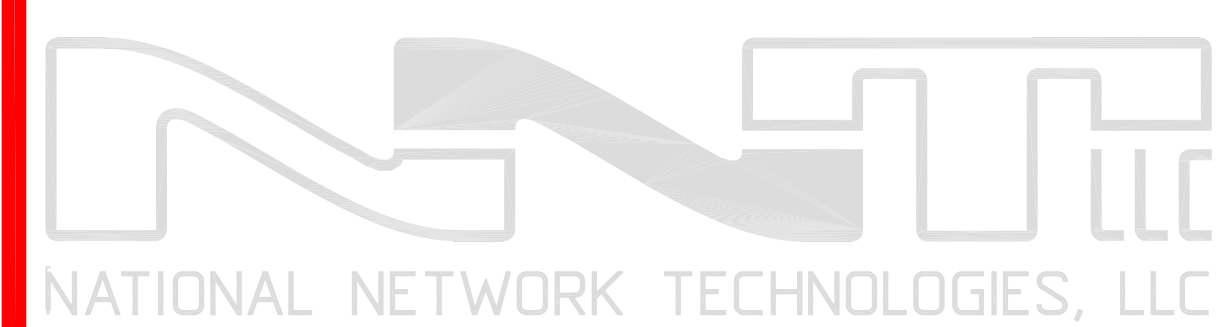


Level (3)SM
 COMMUNICATIONS

LOOP: SOMERVILLE
 SEGMENT: C-5G
 SITE ADDRESS: SOMERVILLE, MA

TITLE: ELM ST

CONTRACT NO:	8724	SHEET: 16 OF: 24
DRAWING NO:	SOM8724P012R1	
DATE DRAWN:	APR2000	
SCALE:	1" = 40'	
PLOT DATE:	4/18/03	

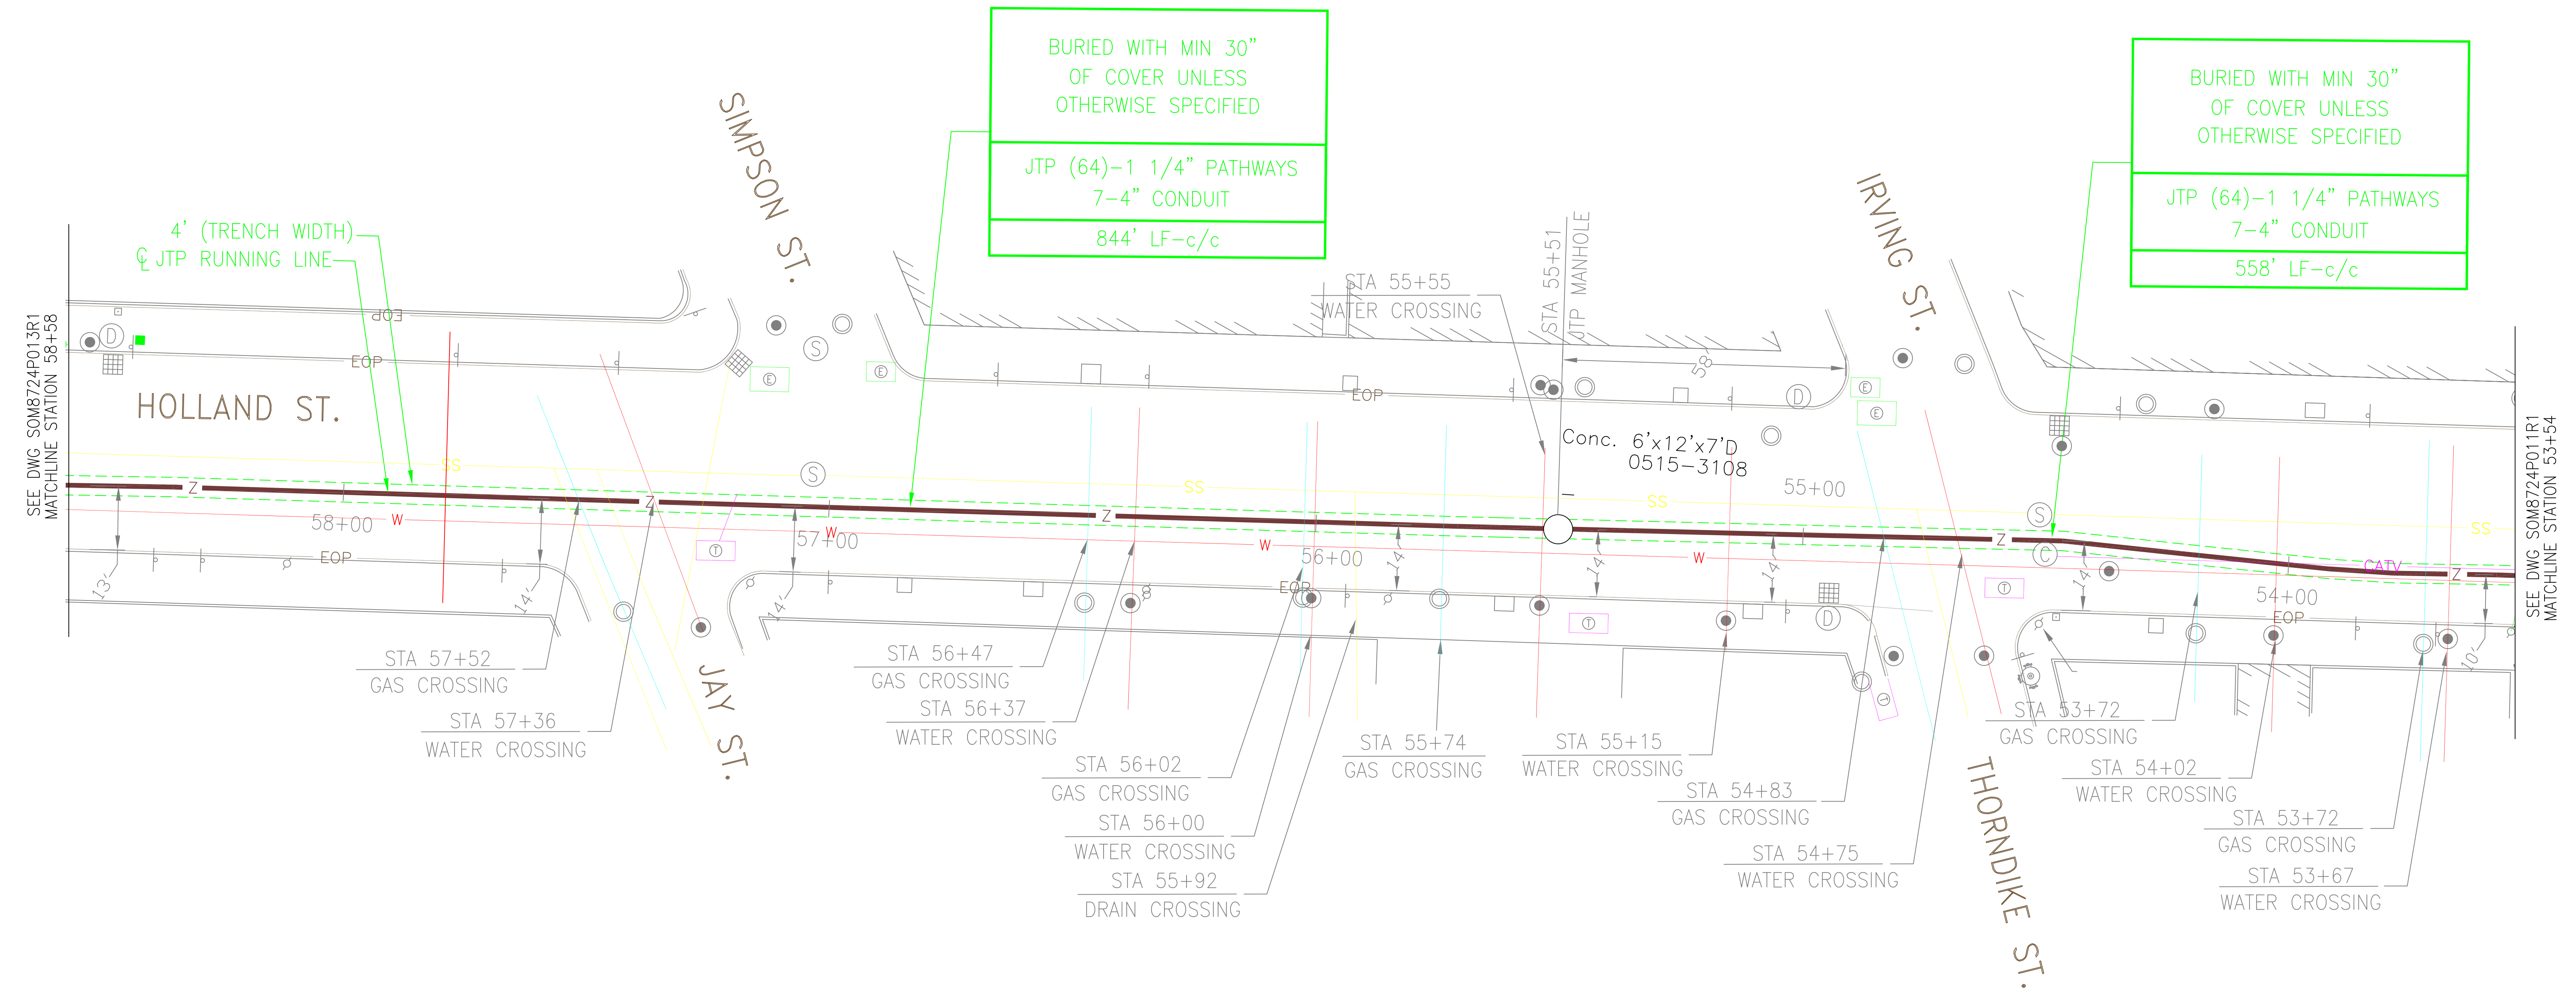

BURIED WITH MIN 30"
 OF COVER UNLESS
 OTHERWISE SPECIFIED
 JTP (64)-1 1/4" PATHWAYS
 7-4" CONDUIT
 844' LF-c/c

BURIED WITH MIN 30"
 OF COVER UNLESS
 OTHERWISE SPECIFIED
 JTP (64)-1 1/4" PATHWAYS
 7-4" CONDUIT
 558' LF-c/c

