


REV	DATE	DESCRIPTION	DESIGNED	CHECKED	BY
1	MAR2001				
2	4/18/03	Changed Level 3 reference to JTP	LM	BW	BW

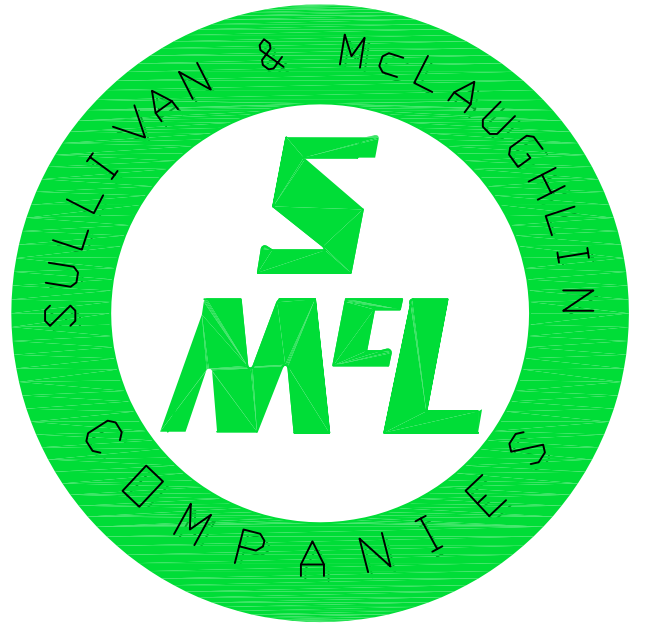

**SULLIVAN & MCLAUGHLIN CO.**  
 74 LAWLEY STREET, BOSTON, MA 02122  
 PHONE: (617) 474-0500 FAX: (617) 474 0505

**CONFIDENTIAL**  
 FOR PROPRIETARY USE ONLY  
 EXCEPT AS MAY BE OTHERWISE PROVIDED  
 THIS DRAWING SHALL REMAIN THE PROPERTY OF  
**Level (3)**  
 COMMUNICATIONS  
 AND SHALL NOT BE REPRODUCED, COPIED, OR USED FOR  
 ANY PURPOSE WITHOUT SPECIFIC WRITTEN PERMISSION.

DRAWN BY: R. MEJIA

CHECKED BY: J. DE BARROS

APPROVED BY: H. BERTONI



**Level (3)**<sup>SM</sup>  
 COMMUNICATIONS

LOOP: SOMERVILLE

SEGMENT: C-5G

SITE ADDRESS:  
 SOMERVILLE, MA

TITLE:  
 HOLLAND ST

CONTRACT NO: 8724

DRAWING NO: SOM8724P014R1

DATE DRAWN: APR2000

SCALE: 1" = 40'

PLOT DATE: 4/18/03

SHEET:

18

SHEET: 18 OF: 24

